

KANSAS

WELL COMPLETION REPORT AND DRILLER'S LOG

State Geological Survey WICHITA BRANCH

21-34-43W


S. 21 T. 34S R. 43 W

Loc. C SW/4

SEP

County Morton

640 Acres N

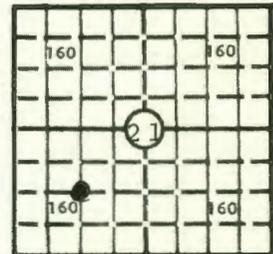

Locate well correctly

Elev.: Gr. 3470'

DF 3474' KB 3475'

API No. 15 — 129 — 20,562
County Number

Operator
Anadarko Production Company

Address
P. O. Box 351, Liberal, Kansas 67901

Well No. 92 Lease Name INTERSTATE UNIT

Footage Location
1320 feet from (XX) (S) line 1320 feet from (E) (W) line

Principal Contractor Geologist
Wakefield Drilling Co., Inc. Mr. Jim Druyff

Spud Date Date Completed Total Depth P.B.T.D.
10/5/81 12/9/81 4270' 4227'

Directional Deviation Oil and/or Gas Purchaser
not applicable National Co-op Refinery

CASING RECORD

Report of all strings set — surface, intermediate, production, etc.

Purpose of string	Size hole drilled	Size casing set (in O.D.)	Weight lbs/ft.	Setting depth	Type cement	Sacks	Type and percent additives
Surface	12-1/4"	8-5/8"	24#	1163'	Pozmix Common	500 200	2% CaCl 3% CaCl
Production	7-7/8"	5-1/2"	10.5#	4270'	Pozmix	120	.5% Tic

LINER RECORD

PERFORATION RECORD

Top, ft.	Bottom, ft.	Sacks cement	Shots per ft.	Size & type	Depth interval
			4	.46	4122-28'

TUBING RECORD

Size	Setting depth	Packer set at
2-7/8"	4169'	

ACID, FRACTURE, SHOT, CEMENT SQUEEZE RECORD

Amount and kind of material used	Depth interval treated
NONE	

INITIAL PRODUCTION

RECEIVED STATE CORPORATION COMMISSION

DEC 18 1981

Date of first production 12/9/81 Producing method (flowing, pumping, gas lift, etc.) Pumping

RATE OF PRODUCTION PER 24 HOURS Oil 38 bbls. Gas 8.4 MCF Water 386 bbls. Gas-oil ratio 221

CONSERVATION DIVISION Wichita, Kansas

Disposition of gas (vented, used on lease or sold) To be Sold Producing interval (s) Purdy Morrow 4122-28'

INSTRUCTIONS: As provided in KCC Rule 82-2-125, within 90 days after completion of a well, one completed copy of this Drillers Log shall be trans-

Operator Anadarko Production Company		DESIGNATE TYPE OF COMP.: OIL, GAS, DRY HOLE, SWDW, ETC.:
Well No. 92	Lease Name INTERSTATE UNIT	OIL
S <u>21</u> T <u>34</u> R <u>43</u> Ex W		


WELL LOG

Show all important zones of porosity and contents thereof; cored intervals, and all drill-stem tests, including depth interval tested, cushion used, time tool open, flowing and shut-in pressures, and recoveries.

SHOW GEOLOGICAL MARKERS, LOGS RUN, OR OTHER DESCRIPTIVE INFORMATION.

FORMATION DESCRIPTION, CONTENTS, ETC.	TOP	BOTTOM	NAME	DEPTH
Conductor	0'	74'	LOGS: GEARHART Compensated Density Compensated Neutron Log Dual Induction Laterolog	
Redbed & Gyp	74'	850'		
Sand	850'	914'		
Gyp and Redbed	914'	1140'		
Redbed & Anhydrite	1140'	1164'		
Anhydrite & Redbed	1164'	1255'		
Redbed & Shale	1255'	2335'		
Redbed, Shale w/Lime Streaks	2335'	2510'		
Shale	2510'	2720'		
Shale & Lime	2720'	3370'		
Lime & Shale	3370'	3595'		
Shale & Lime	3595'	3750'		
Lime & Shale	3750'	4270'		
RTD		4270'		

USE ADDITIONAL SHEETS, IF NECESSARY, TO COMPLETE WELL RECORD.

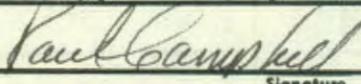Date Received	
	Signature
	Paul Campbell, Division Operations Manager
	Title
	December 11, 1981
	Date

51-34-43M

e610h9

21-34-43W

KANSAS DRILLER'S LOG

State Geological Survey
WICHITA BRANCH
SEP

LEASE: INTERSTATE UNIT #92
OWNER: ANADARKO PRODUCTION COMPANY
SPUD: 10-05-81
COMP: 10-13-81

LOCATION: 1320' FW & SL
SECTION 21-34S-43W
MORTON COUNTY, KANSAS
CASING: 8 5/8" SET @ 1164'
5 1/2" SET @ 4270'

Conductor	74
Red Bed & Gyp	850
Sand	914
Gyp & Red Bed	1140
Red Bed & Anhydrite	1164
Anhydrite & Red Bed	1255
Red Bed & Shale	2335
Red Bed, Shale W/Lime Streaks	2510
Shale	2720
Shale & Lime	3370
Lime & Shale	3595
Shale & Lime	3750
Lime & Shale	4270
R.T.D.	4270

RECEIVED
STATE CORPORATION COMMISSION

DEC 18 1981

CONSERVATION DIVISION
Wichita Kansas

STATE OF KANSAS)
) ss.
COUNTY OF SEDGWICK)

I, William C. Wakefield, do hereby certify that this is a true and correct
Driller's Log on the INTERSTATE UNIT #92, located 1320' FW & SL SECTION 21,
TOWNSHIP 34 South, RANGE 43 West, MORTON COUNTY, KANSAS, as shown by the daily
drilling reports.