

5


34

4W

SECTION _____ TOWNSHIP _____ RANGE _____

WELL NO. #1 Nathala (Netahla)

COMPANY A.F. Brann & Adair Oil

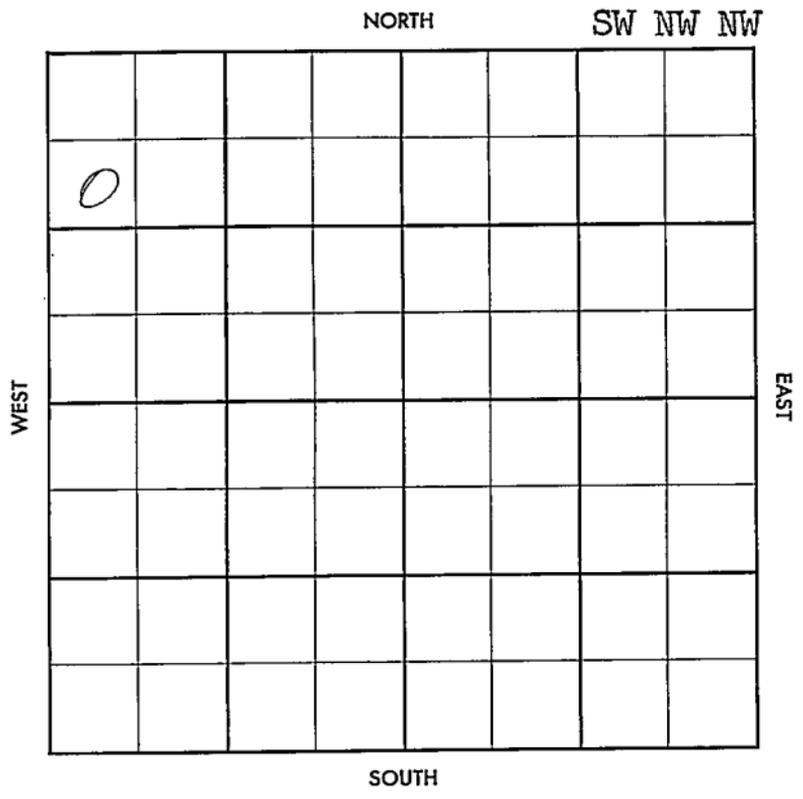

County Sumner Elev. _____
 Sec. 5 Twp. 34 Rge. 4W
 Company A. F. Brann & Adair Oil
 Farm Name Nathala No. 7

TOPS	DEPTH	LOG	DATUM	Loc. in Sec.
Anh.				SW NW NW
TP.				
H.				
Tr.				
Dg.				
Bl.				
L.				Geol. _____
K.C.				Contr. _____
B.K.C.				
Ce.				Co. Tools
C.				
M.				Pool
M.				<u>BERBERDING</u>
K.				
Mz.				
Mq.				
V.				
S.				
S.				
A.				
R.				
PE.				FIRST REPORT
G.				
TD.				

Date Comm. 4-1-57
8" @ 203/150 WOC

28

Co.
Lse.
F.No.
Sec.
T.
R.

County Sumner Elev. 1240
 Sec. 5 Twp. 34 Rge. 4W
 Company A. F. Brann & Adair Oil
 Farm Name Nathala No. 1

TOPS	DEPTH	LOG	DATUM	Loc. in Sec.
Anh.	1350			SW NW NW
Ip.				
H.				
Tr.				
Dg.				
BL				
L.				Geol. <u>GR</u>
K.C.	3614			Contr.
B.K.C.				Co. Tools
Ce.				
C.				
M.	4306			
M.				Pool
K.				<u>Gerberding</u>
Mz.				
Me.				
V.				
S. <u>sd</u>	4731			JUN 12 '57
S.				
A.				
R.				
PE.				
G.				ABANDONED
T.D.	4733			

Date Comm. 4-1-57
8" G 203/150, WOC 710' 3011
APR 17 '57 DST 3613-24 1hr 300' SW
BHP #950 4272 APR 4 '57 ✓
MAY 1 '57 DST 4713-28 1hr 65'
Md BHP 1982/20 5 1/2 4733
BWP WOC MAY 15 '57 DD 4734
PF 18/4730 1/2 - 33 MAY 22 '51 1st 3 60ph
+ 1/2 Bwp nat 1/2 Frac. MAY 29 '57
JUN 5 '57 \$ 60 D. F. P. 5000 SW
PRU JUN 12 '57 DECA