


Section 5 Township 34 Range 11W

Well No. 1 Groendyke

Company M. B. Armer

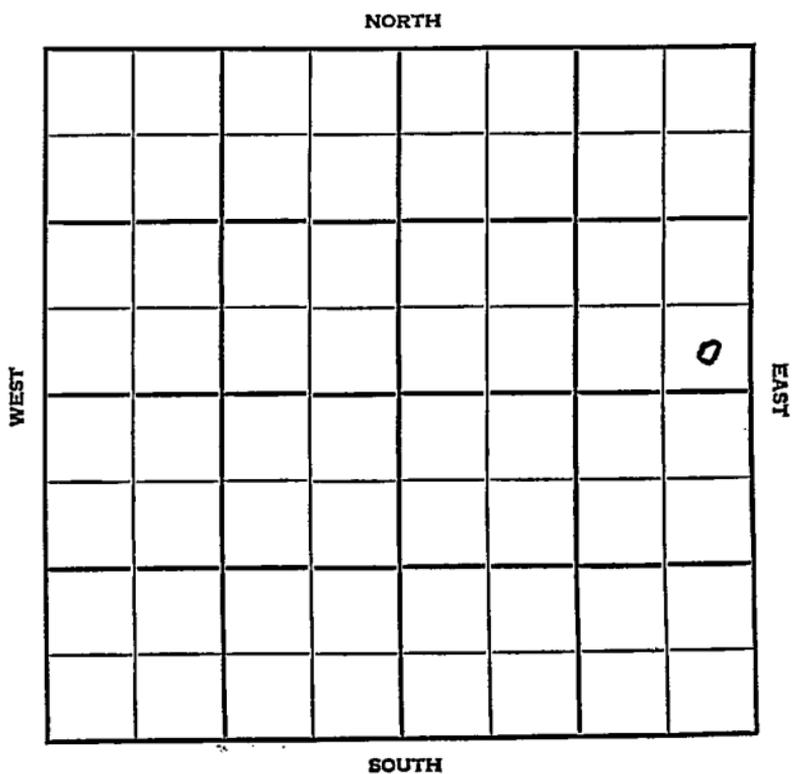

Barber KANSAS

|      |      |     |
|------|------|-----|
| SEC. | TWP. | R.  |
| 5    | 34   | 11W |

WELL NO. **1 Groendyke** FARM

COMPANY **M. B. Armer**

CONTRACTOR **Armer**


**Wildcat**

\_\_\_\_\_ Ft. from N. Line

**330** \_\_\_\_\_ Ft. from S. Line

**330** \_\_\_\_\_ Ft. from E. Line

\_\_\_\_\_ Ft. from W. Line

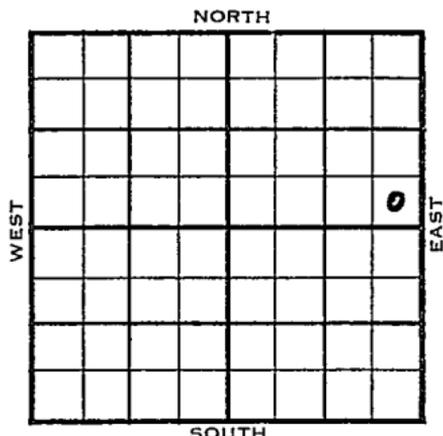

SE SE NE  
Superior FO

|      |           |        |
|------|-----------|--------|
| 1954 | ELEVATION | REPORT |
|      | 1389'     |        |

9/8 Location  
10/6 Spud 9-18-54 D & A TD 4650  
8-5/8" @ 234 Anhy 1240 Elgin sd 3471  
Heeb 3610' Lans 3766 B KC 4138  
Miss 4523'  
DST 4570-4650 open 2 hrs rec 360'  
mud, 1830' SW 1750# TD 4650'  
D & A

**ABANDONED**



