

Barber

KANSAS

5

34

11W

SECTION _____ TOWNSHIP _____ RANGE _____


#1 Groendyke

WELL NO. _____

Honaker-Davis

COMPANY _____

NORTH SW NW

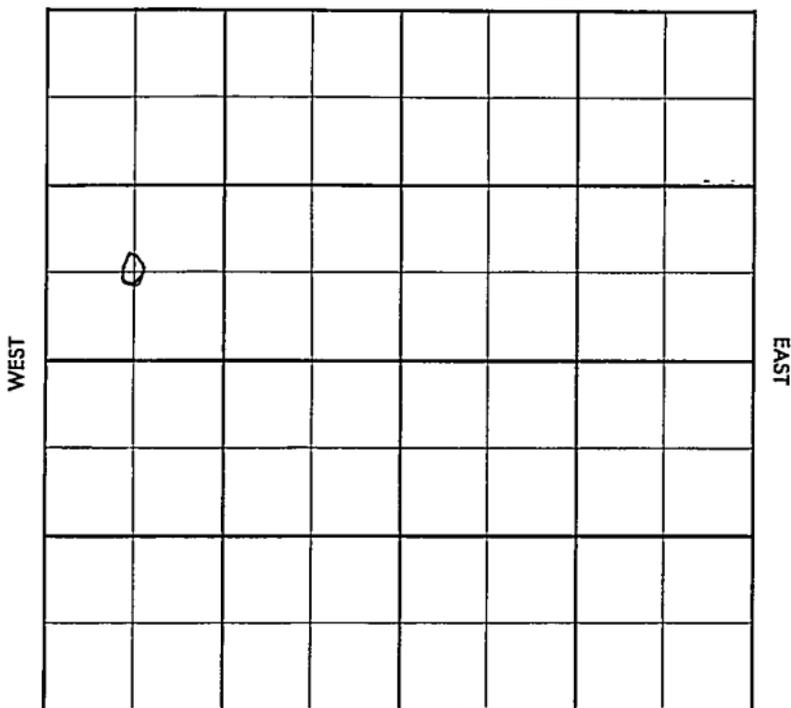

SOUTH

DST 4986-5003 ga 22" new
80' Md BHP 880 5 1/2 e

4700 / 125 MAR 13 '57 MAR 21 '57 MAR 21 '57

CO 4673 96/4554-78 1/2

FRAC 12 x 12 ga est

10 Mill CFG ga 4,600 MCFG

FCP 1500 FTP 1200 SICP

1675 SITP 1650 APR 3 '57 S.I.

'57 C.50 op Flw 11 Mill
CFG SIP 1800#

County Barber Elev. 1410
 Sec. 5 Twp. 34 Rgs. 11W
 Company Honaker-Davis
 FarmName Groendyke No. 1

	TOPS	DEPTH	LOG	DATUM
Anh.				
Ip.				
H.		3620		
Tr.				
Dg.				
Bl.				
L.		3839		
K.C.				
B.K.C.				
Ce.				
C.				
M.		4525		
M.				
K.		4770		
Mz.				
Mo.				
V.		4886		
S.		4987		
S.				
A.				
R.				
Pe.				
G.				
T.D.		5014		

Loc. in Sec. SW NW
 Geol. _____
 Contr _____
 Co. Tools _____
 Pool _____

APR 0 57
 COMPLETE

Date Comm. 2-12-57

8" @ 210/250, Drlg. 3302 FEB 17 57

DST 4530-55 cor 50" rec
 124 MCFG/10" + 56' SGCM
 FP 65-28 BHP 1360/20
 DST 4555-83 1hr rec 416
 MCFG/20" + 148 GCM FP 540
 -601 BHP 1810/20" DST 4583
 -4616 1hr rec 28' VSD 8' GCM
 FP 48-48 BHP 585/20" D 4680

Co.

L.S.

No.

Sec.

T.

R.

County Barber Elev. _____
 Sec. 5 Twp. 34 Rge. 11W
 Company Honaker-Davis
 FarmName Groendyke No. 1

Co.
Lse.
No.
Sec.
T.
R.

TOPS	DEPTH	LOG	DATUM
Anh.			
Tp.			
H.			
Tr.			
Dg.			
Bl.			
L.			
K.C.			
B.K.C.			
Ce.			
C.			
M.			
M.			
K.			
Mz.			
Mo.			
V.			
S.			
S.			
A.			
R.			
PE.			
G.			
TD.			

Loc. in Sec. SW NW
 Geol. _____
 Contr. _____
 Co. Tools _____
 Pool _____

FIRST REPORT
 FEB 20 57

Date Comm. 2-12-57
8" @ 210/250, Drlg. 3302

26