


Barber

KANSAS

SECTION 5 TOWNSHIP 34 RANGE 13W

WELL NO. #1-Blunk "CW"

COMPANY Imperial Petr.

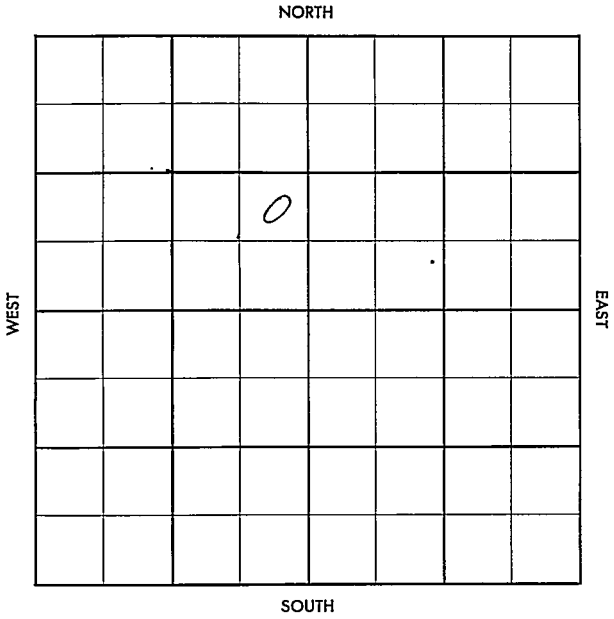

SEC.

TWP.

R.

5

34

13W

WELL NO.

#1 Blink "C"

FARM

COMPANY

Imperial Petr.

CONTRACTOR

Patton

SW Medicine Lodge

NORTH

Ft. from N. Line

Ft. from S. Line

Ft. from E. Line

Ft. from W. Line

NE SE NW

1956
11/14

ELEVATION
1876'

REPORT

4-4

Comm. 3-28-56

5-9

13" @ 237 w/250

DST 4170-4274 op 1 hr. rec. 30' mud,
360#

DST 4871-4900 op 1 hr. rec. 45' mud,
170#.

DST 4863¹/₂4974 op 1 hr. rec. 250' mdu
160#

D&A

H. 4110', Dg. sd 4198', L. 4310',
M. 4870'.

~~##~~ TD 4974'.

ABANDONED

County Barber Elev. _____
 Sec. 5 Twp. 34 Rge. 13W
 Company Imperial Pet.
 Farm Name Blunk "C" No. 1

TOPS

DEPTH

LOG

DATUM

Loc. in Sec.

NE SE NW

Anh.

Tp.

H.

Tr.

Dg.

Bl.

L.

K.C.

B.K.C.

Ce.

C.

M.

M.

K.

Mz.

Mq.

V.

S.

S.

A.

R.

P.E.

G.

T.D.

Geol.

Contr.

Patton

Pool

SW Medicine
Lodge

	0	
FIRST REPORT		
	APR 4	'56

Date Comm.

3-28-56

Co.

Lse.

No.

Sec.

T.

R.

County Barber Elev. 1876
 Sec. 5 Twp. 34 Rge. 13W
 Company Imperial Pet.
 Farm Name Blunk "C" No. 1

TOPS	DEPTH	LOG	DATUM	Loc. in Sec.
Anh.				NE SE NW
TP.				
H.	<u>4110</u>			
Tr.				
Dg. <u>sd</u>	<u>4198</u>		<u>2322</u>	
BL.				
L.	<u>4310</u>		<u>2434</u>	Geol.
K.C.				Contr.
B.K.C.				Patton
Ce.				
C.				Pool
M.				SW Medicine
M.	<u>4870</u>		<u>2994</u>	Lodge
K.				
Mz.				
Mo.				
V.				
S.				
S.				
A.				
R.				
Pe.				
G.				
T.D.	<u>4974</u>			

Date Comm. 3-28-56 MAY 9 1956

13" @ 237/250 DST 4170-4274 open 1 hr.

rec. 30' mud 360# DST 4871-4900

open 1 hr. rec. 45' mud 170#

DST 4863-4974 open 1 hr. rec. 250' mud
160#

D & A

ABANDONED