

Barber KANSAS


SEC.	5	TWP.	34	R.	13W
------	---	------	----	----	-----

WELL NO. 1 Blunk FARM

COMPANY Imperial Petroleum Co.

CONTRACTOR Patton Wildcat

_____ Ft. from N. Line
 990
 _____ Ft. from S. Line
 _____ Ft. from E. Line
 990
 _____ Ft. from W. Line

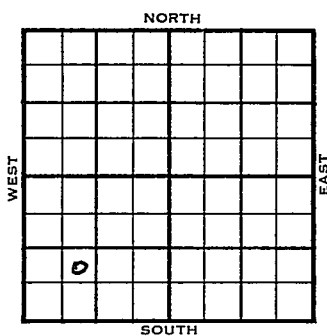

NE SW SW

1954	ELEVATION	REPORT
	1858'	
7/7	M I R	
7/21	8" @ 510	Heeb 4094 Doug 4205 Lans. 4305 Drlg. 4478
8/25	Spud 7-7-54	SI gas well TD 5515' 8" @ 510 Heeb 4094 Doug 4205' Lans. 4305 Miss 4862 DST 4864-74 open 1 1/2 hr rec 270' gas, 15' GCM 693# EST 4876-96 open 1 1/2 hr rec 75,000 CFG 45' SGCM 1509# DST 4958-92 open 1 1/2 hr rec 30' mud 88# Viola 5184 Simp sh. 5325' Simp. sd. 5340' DST 5341-52 open 1 hr rec 30' SO & GCM 166# DST 5370-80 open 1/2 hr rec 10' mud Arb. 5495 TD 5515' 5" @ 5095 36/4876-82 B/30 GWPH SI 13 hr. B/36 GWPH 500 A A-frac F/1 BOPH HGC Comp. shut in gas well. 2,530,000 CFGPD
COMPLETED		

