


Section 5 Township 34 Range 2W
Well No. 1 Brownback
Company South Texas Dev. Co.

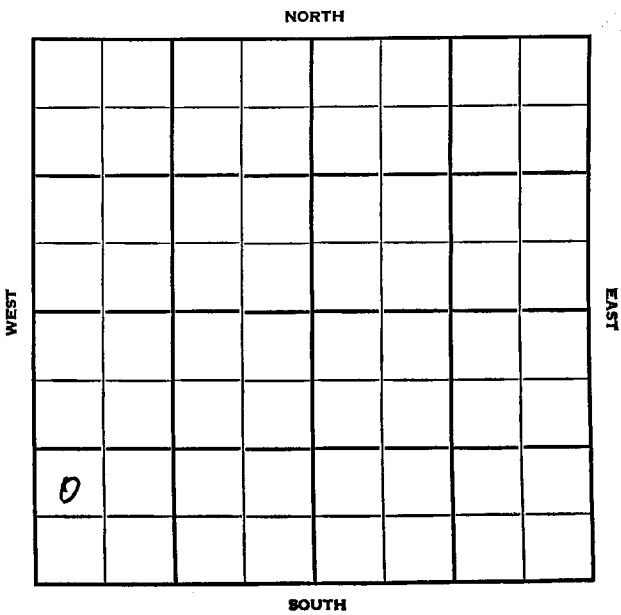

Sumner

KANSAS

SEC.	TWP.	R.
5	34	2 W

WELL NO.

1 Brownback

FARM

COMPANY

South Texas Dev. Co.

CONTRACTOR

Anschutz

Wildcat


_____ Ft. from N. Line

990 _____ Ft. from S. Line

_____ Ft. from E. Line

330 _____ Ft. from W. Line

NW SW SW

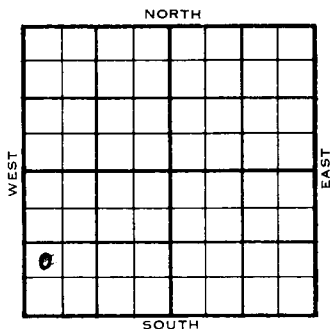


Alpine FO

	ELEVATION	REPORT
--	-----------	--------

1955

4/20

Spud 4-12-55
10" @ 423
Drlg. 2362'

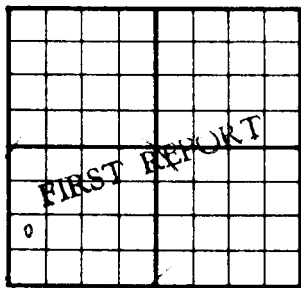County Sumner State KansasSec. 5 (Blk. Twp.) 34 (Sur. Rge.) 2W Map No.Operator South Texas Dev. Co.Well No. 1 Farm BrownbackElev. Location NE SW SW890 Ft. From S Line SW330 Ft. From W Line Quarter1st. Report APR 20 1955

Completion

Remarks Alpine farmoutAnschutz - Contr.Spudding Date 4-12-55Drlg. Data Wildcat10" @ 423 drlg. 2362

FABEN GILSTRAP