


Section 5 Township 34 Range 2 W

Well No. # 1 Roy

Company Alpine Oil & Royalty

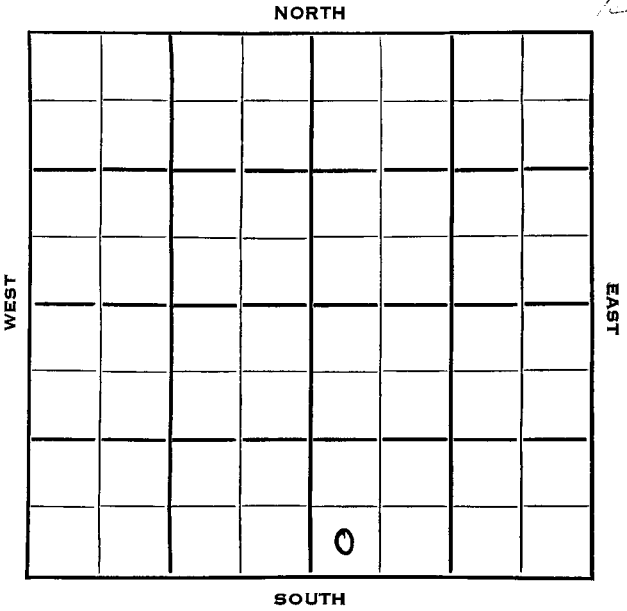

Sec. 5 Twp. 34 R. 2W

Well No. #1 Roy Farm

Alpine Oil & Royalty Company

Quaker Drlg. Contractor
Wildcat


 Ft. from N. Line

330 Ft. from S. Line

 Ft. from E. Line

330 Ft. from W. Line

SW SW SE

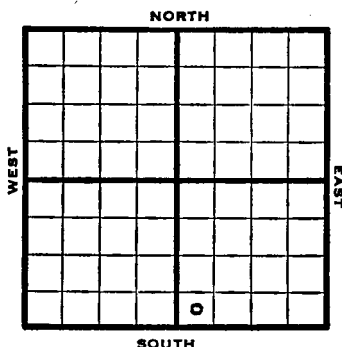

1953 Elev. 1130' REPORT

5/20 Location

5/28 8" @ 500
Drlg. 1255'

6/3 Drlg. 3475'

6/10 Top 2229 Stal 2980 Lay 3350
KC 3405 Miss 4070
Drlg. 4150'

6/24 DST 4076-95, 1 hr., 59' M, 750#
Chat 4443, Simp 4522
Drlg. 4578'

7/1 Spud 5-21-53

D & A

TD 4582'

8" @ 500'

Top. 2229, Stal. 2980, Layton 3350, K
3405, Miss 4070,

DST 4076-95 opn 1 hr, rec 59' mud
750# Chat 4443, Simp 4522, Misener
4500, Viola 4504

DST 4520-28 opn 1 hr, rec 20' sw
1760#

DST 4557-65 opn 1 hr, rec 50' sw
1630#

TD 4582'

D & A

ABANDONED

County **Sumner** State **Kansas**

Sec. 5 (Blk. Twp.) 34 (Sur. Rge.) 2W Map No.

Operator **Alpine Oil & Royalty**

Well No. **1** Farm **Roy**

Elev.	Location	SW	SW	SE
-------	----------	----	----	----

330 Ft. From **S** Line **SE**

330 Ft. From W Line Quarter

1st. Report MAY 20 1953

Completion


Remarks

Quaker Drlg. - Contr.

Spudding Date _____

Orig. Data **Wildcat**

Location

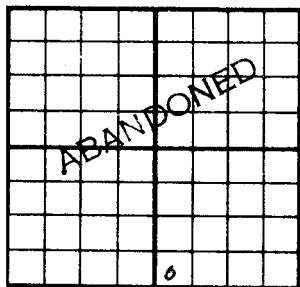County Sumner State KansasSec. 5 (Blk. 34 (Sur. 2 W Map No.
(Twp.) (Rge.)Operator Alpine Oil & RoyaltyWell No. 1 Farm RoyElev. 1130 Location SW SW SE330 Ft. From S Line SE330 Ft. From W Line Quarter1st. Report Completion 1111 1 1953Remarks WildcatQuaker Drlg. - Contr.Spudding Date 5-21-53Drlg. Data D & A TD 45828" @ 500 Top. 2229 Stal. 2980Layton 3350 KC 3405 Miss. 4070DST 4076-95 open 1 hr. Rec. 59' mud750# Chat 4443 Simp. 4522Misener 4500 Viola 4504 DST 4520-28open 1 hr. Rec. 20' sw 1760#DST 4557-65 open 1 hr. Rec. 50' sw1630# TD 4582D & A