


Section 5 Township 34 Range 33-W

Well No. #1 Anthony

Company C S O & Texas

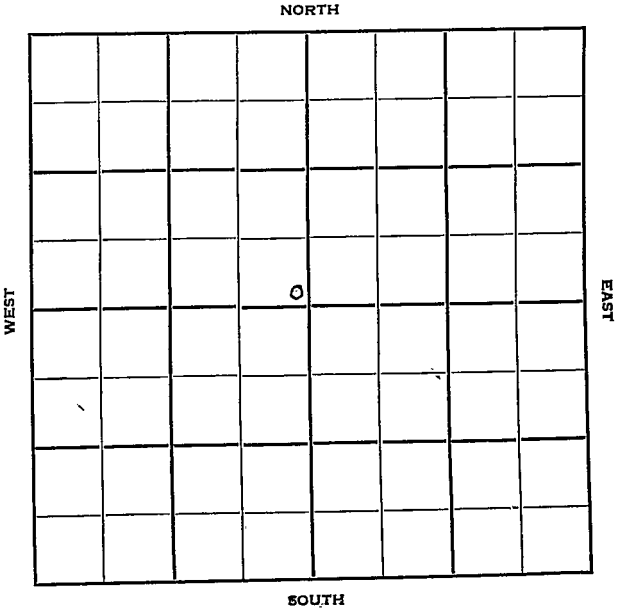

Seward

KANSAS

Sec. 5 Twp. 34 R. 33W

Well No. #1 Anthony Farm

C SO & Texas Company

Barbour Contractor

Hugeton Pool


Ft. from N. Line

100' Ft. from S. Line

100' Ft. from E. Line

Ft. from W. Line

SE NW

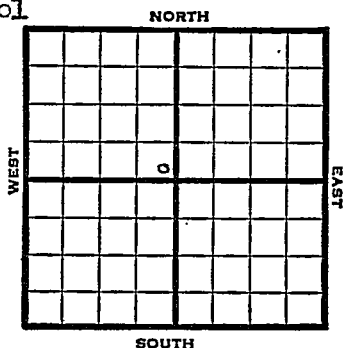

1950 Elev 2878 REPORT

6/21 Spud 6-15-50
8" @ 639'
Drilg. 2410'

8/16 8" @ 639
Her 2636 Krider 2660
Win 2746
TD 2785
5" @ 2784
30/2746-52, 20/2728-32, 150/2692-2722
40/2660-68, 40/2636-44 4000 A
PB 2725 1000 A 2636-68
2000A 2692-2722 wtr PB 2716 wtr
SP 2678 24/2636-44, 24/2660-68
6000 A 70/2692-2706 1500 A
56/2690-2706 3000 A
Comp 5,110,000 opn flow
Completed

COMPLETED


Map No. _____ Sec. 5 Twp. 34 R. 33WWell No. 1 AnthonyC S O & Texas CompanyBarbour ContractorSE NT

SECTION PLAT

_____ Ft. from N. Line

100 Ft. from S. Line100 Ft. from E. Line

_____ Ft. from W. Line

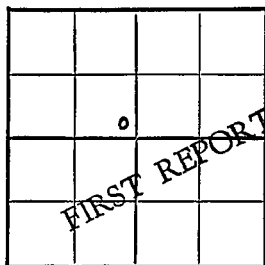Seward County

Location _____

Rig up _____

Drilling and Remarks: _____

Spud 6-15-50

8" @ 639

drlg. 2410

RECORD

Cased _____ in., _____ ft.

Sand _____

Gas _____

Oil _____

Total Depth _____

PRODUCTION

1st 24 hrs. Nat. _____

1st 24 hrs. after shot _____

Gas _____ Cu. Ft.

Dry Hole _____

Abandoned _____

Date

JUN 21 1950 19 J. E. TYRA Scout


Map No. _____ Date _____

W. H. H.

County _____

City _____

SECTION PLAT

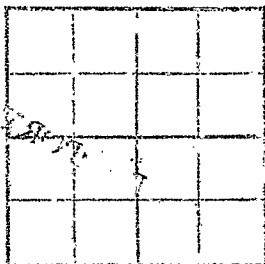

Tr. from N. Line _____

Tr. from E. Line _____

Tr. from S. Line _____

Tr. from W. Line _____

RECORD

Class _____ in _____

Book _____ Page _____

Tr. from _____

Tr. from _____

NOV 23 1950

Scout Cards

Land Small Map

Land Walk Map

Tracings

France Map

Pierce Map

Misc.

Chas

Book

or

10

County Seward State Kansas
 Sec. 5 (Blk. 34) (Sur. 33W) - Map No.
 Operator Cities Service & Texas
 Well No. 1 Farm Anthony
 Elev. 2878 Location SE NW

COMPLETE

0

100 Ft. From S Line NE

100 Ft. From E Line Quarter

1st. Report

Completion AUG 16 1950

Remarks

Spudding Date 6-15-50

Drlg. Data Gas well TD 2785

8" @ 639 Her. 2636 Krider 2660

Win. 2746 TD 2785 5" @ 2784

30/ 2746-52 20/ 2728-32 150/ 2692-2722

40/ 2660-68 40/ 2636-44 4000A

PB 2725 21000 A 2636-68

2000 A 2692-2722 water PB 2716 water

SP 2678 24/ 2636-44 24/ 2660-68

6000 A 70/ 2692-2706 1500 A

56/ 2690-2706 3000 A

Comp. 5,110,000 open flow

J. E. TYRA

AUG 21 1950

Scout Cards 7 w
Land Small Map
Land Wall Map 5
Tracings
France Map
Pierce Map
Misc.

Orig. Data