

KANSAS


FORM 51 25M 3-49 PETROL

Seward

Section 5 Township 34 Range 34-W

Well No. #1 Fincham

Company Plains Natural Gas

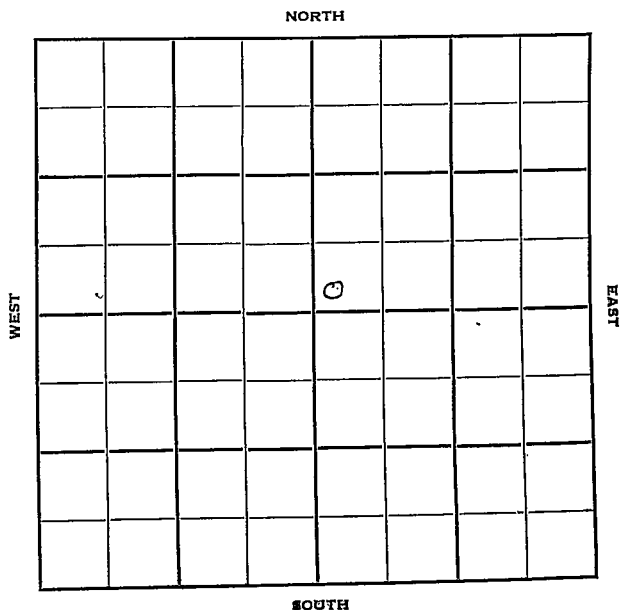

Seward

KANSAS

Sec. 5 Twp. 34 R. 34W

Well No. #1 Fincham Farm

Plains Natural Gas Company

Hugoton Pool

 Ft. from N. Line


200' Ft. from S. Line

 Ft. from E. Line

200' Ft. from W. Line

SW NE

Gas Well

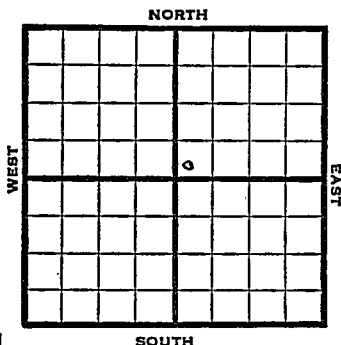

1950 Elev. 2941' REPORT

9/13 Spud 9-9-50
10" @ 752'
Drlg. 1500'

10/11 10" @ 752
7" @ 2755
TD 2759
240/2702-42, 30/2687-92, 36/2674-80
60/2648-58, 24/2640-44
Hol 2578 Her 2639
Kridler 2673 Win 2753
12000 total acid
Comp 2,132,000 gas
Completed

COMPLETED

County Seward State KansasSec. 5 (Blk. Twp.) 34 (Sur. Rge.) 34W Map No.Operator Plains Natural GasWell No. 1 Farm FinchamElev. 2041 Location SW NE

0

FIRST REPORT

200 Ft. From S Line NE200 Ft. From W Line Quarter1st. Report SEP 13 1950

Completion

Remarks

Spudding Date 9-9-50Drlg. Data Hugoton Pool10" @ 752 drlg. 1500

J. E. TYRA

J. E. TYRA