
FORM 51 25M 8-50 WESTERN Morton KANSAS

Section 5 Township 34 Range 40 W

Well No. # 1 Bohn "C"

Company Cities Service

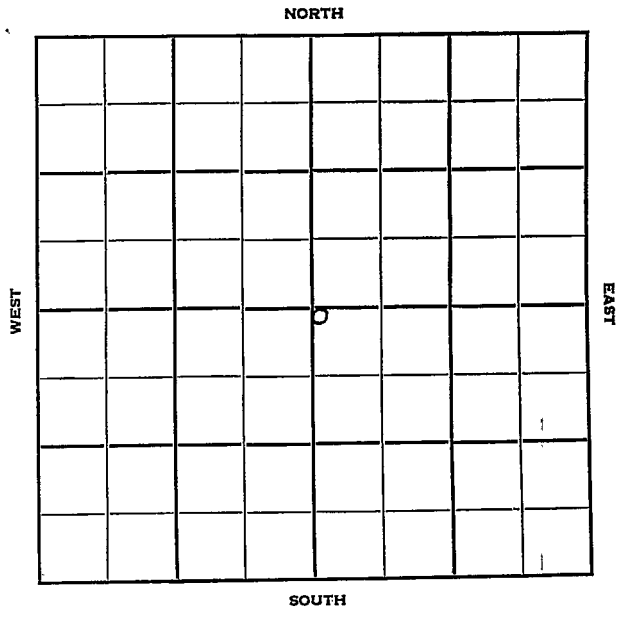

FORM 252-B
10M 11-50 PETROL

Morton KANSAS

Sec. 5 Twp. 34 R. 40 W

Well No. # 1 Bohn "C" Farm

Cities Service Company

Contractor

Hugoton Pool


100 Ft. from N. Line

Ft. from S. Line

Ft. from E. Line

100 Ft. from W. Line

NW SE

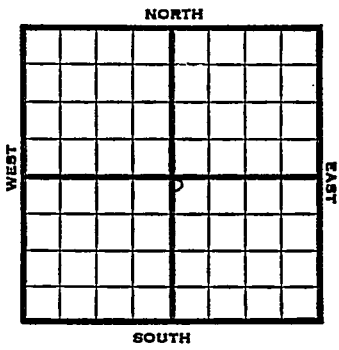

1951	Elev. 3348' REPORT
4/11	Cellar & Pits
5/29	Spud 4-12-51 Gas Well TD 2590 8" @ 480 Krider 2397 Win. 2463 Ft. Riley 2540 TD 2590 5" @ 2589 CO to 2557 25/2550-56 30/2542-48 40/2500-08 110/2474-96 20/2466-70 30/2436-42 50/2422-32 80/2402-18 22,500 A Comp. 6,140,000 gas 402# COMPLETED

FORM 275 FOR SALE BY KANSAS BLUE PRINT CO.


County Morton State Kansas

Sec. 5 (Blk. / Twp.) 34 (Sur. / Rge.) 40W Map No.

Operator Cities Service

Well No. 1 Farm Bohn "C"

Elev. Location NW SE

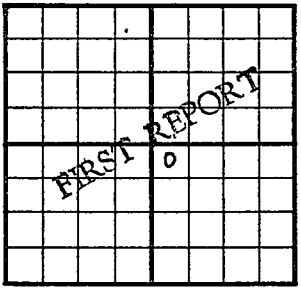

100 Ft. From N Line SE

100 Ft. From W Line Quarter

1st. Report APR 11 1951

Completion

Remarks

Spudding Date

Drlg. Data Hugoton Pool

Cellar & pits

J. E. TYRA

FORM 275 FOR SALE BY KANSAS BLUE PRINT CO.


County Morton State Kansas

Sec. 5 (Blk. / Twp.) 34 (Sur. / Rge.) 40W Map No.

Operator Cities Service

Well No. 1 Farm Bohn "C"

Elev. 3348 Location NW SE

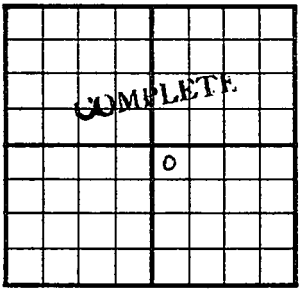

100 Ft. From N Line SE

100 Ft. From W Line Quarter

1st. Report

Completion MAY 29 1951

Remarks Hugoton Pool

Spudding Date 4-12-51

Drlg. Data Gas well TD 2590

8" @ 480 Krider 2397 Win. 2463

Ft. Riley 2540 TD 2590 5" @ 2589

CO to 2557 25/ 2550-56 30/ 2542-48

40/ 2500-08 110/ 2474-96 20/ 2466-70

30/ 2436-42 50/ 2422-32 80/ 2402-18

22500 A Comp. 6,140,000 gas 402#

J. E. TYRA