Form 26A SM 4-22 5765

Map No. ____ Sec. 24 Twp. 34 R. 6 W

Well No. 1 Mandiville Farm


Acorn et al Company

200 Ft. from N. Line

____ Ft. from S. Line

200 Ft. from E. Line

____ Ft. from W. Line

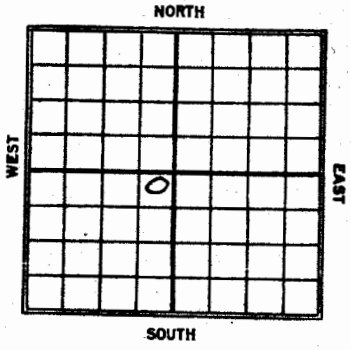

Date 1923	REPORT
6/10	D.T.D. 3775'

Form 26—1M Bks.—3-23—11950.

Map No. KANSAS Sec. 24 Twp. 34 R. 6W

Well No. 1 Mandiville

Acorn et al Company

Contractor

FIRST REPORT

200 Ft. from N. Line


____ Ft. from S. Line

200 Ft. from E. Line

____ Ft. from W. Line

ABANDONED

SECTION PLAT

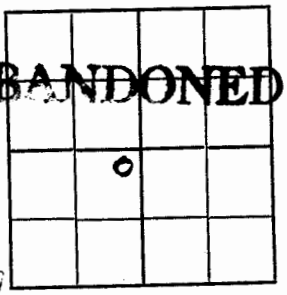

Location ____

Rig up ____

Drilling and Remarks:

D.T.D. 3775
on acct of
fishing Job.

RECORD

Cased ____ in., ____ ft.

Sand ____

Gas ____

Oil ____

Total Depth ____

PRODUCTION

1st 24 hrs. Nat. ____

1st 24 hrs. after shot ____

Gas ____ Cu. Ft.

Dry Hole ____

Abandoned ____

Date JUN 10 1923 192____

M. A. BENEAR Scout