
DX 78-1

Sumner KANSAS

Section 6 Township 34 Range 4W

Well No. 1 Gerberding

Company Time Petrolelum

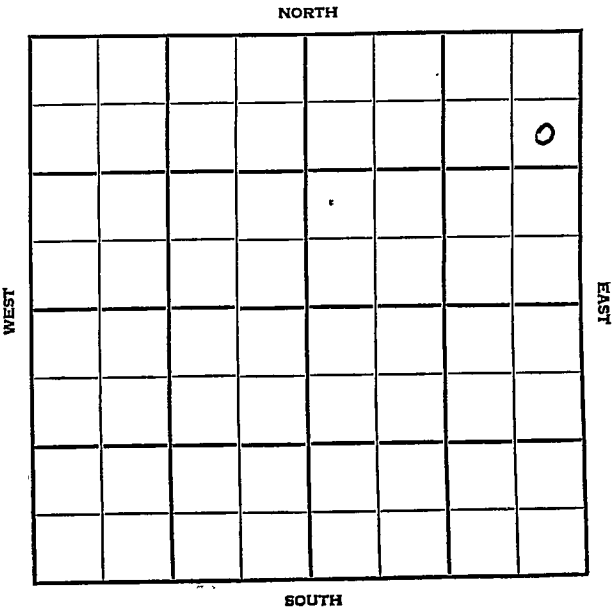

HOT FILE

Sumner KANSAS

SEC.	TWP.	R.
6	34	4W

WELL NO.
1 Gerberding FARM

COMPANY
Time Petroleum

CONTRACTOR


Wildcat

990 Ft. from N. Line

Ft. from S. Line

330 Ft. from E. Line

Ft. from W. Line

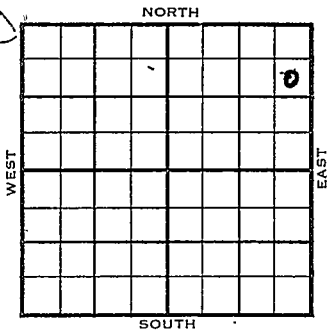

SE NE NE
Skelly DHM

1954 ELEVATION 1228' REPORT

6/23 Spud 6-21-54
8" @ 250'

6/30 ∅ 3200

7/7 KC 3606 Miss 4297
Drlg. 4366

7/13 Waiting on cement with 5½" set in Simpson.
Simpson Sand topped at 4711'
DST 4711-23, open 1 hr, gauged 750,000 dubic feet gas & flowed oil in 40 mins at an estimated rate of 50 bbls per hr. BHP 1885# FP 450#.
Miss. 4297' TD 4723' 5" @ 4712'.
(M. W. McClure holds an interest in the venture with Sunray & Skelly Oil supporting. Operators hold a 560 acre block and selected location for core drill, subsurface and seismograph formation.)

OVER

DX-78

1954
11/23 Spud 6-21-54 - Oil Well
TD 4723'
8" @ 250'
KC 3606', Miss 4297', Simp. 4711',
DST 4712-23, opn 1 hr., gas in 4",
250,000 cfg
F/oil in 40", 50 boph, 3410' free oil
1889#
TD 4723'
5" @ 4713'
CO to 4723', frac,
F/20 bop 3 bwph
P/45 bopd
PB 4721' wtr dec.
20/4710-15, S/1½ boph
P/35 bopd
Comp. 25 bopd 100 bw

COMPLETED

FORM 275 FOR SALE BY KANSAS BLUE PRINT CO.


County Sumner State Kansas

Sec. 6 (Blk. / Twp.) 34 (Sur. / Rge.) 4W Map No.

Operator Time Petroleum

Well No. 1 Farm Gerberding

Elev. 1228 Location SE NE NE

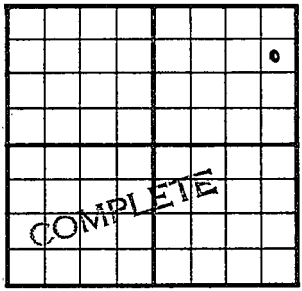

990 Ft. From N Line NE

330 Ft. From E Line Quarter

Ist. Report

Completion NOV 23 1954

Remarks Wildcat

Spudding Date 6-21-54

Drlg. Data Oil well TD 4723

8" @ 250 KC 3606 Miss. 4297 Simp. 4711

DST 4712-23 open 1 hr. gas in 4min.

250,000 cfg F/ oil in 40 min. 50 boph

3410' free oil 1889# TD 4723 5" @ 4713

CO to 4723 frac F/ 20 bo 3 bwph

P/ 45 bopd PB 4721 wtr dec.

20/ 4710-15 S/ 1½ boph P/ 35 bopd

Comp. 25 bopd 100 bw

FABEN GULSTRAP

FORM 275 FOR SALE BY KANSAS BLUE PRINT CO.


County Summer State Kansas

Sec. 6 (Blk. Twp.) 34 (Sur. Rge.) 4W Map No.

Operator Time Petroleum

Well No. 1 Farm Gerberding

Elev. Location SE NE NE

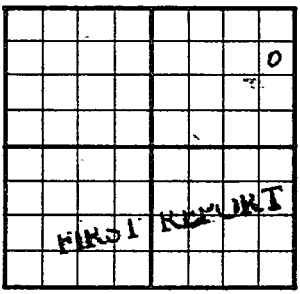

990 Ft. From N Line NE

330 Ft. From E Line Quarter

1st. Report JUN 23 1954

Completion

Remarks Skelly - IHM

Spudding Date 6-27-54

Drlg. Data Wildcat

8" @ 250

J. G. McGEHEE