


Barber

KANSAS

SECTION 6 TOWNSHIP 34S RANGE 12W

WELL NO. #1 McCracken "B"

COMPANY Bachus Oil

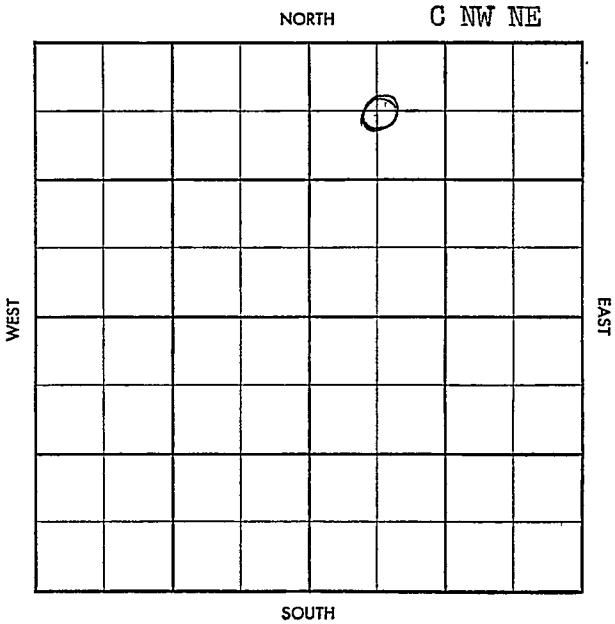

15050F
1508 RB

JAN 15 '88

COMPLETE

FARM McCracken "B"

LOC. _____ C NW NE

GEOL.

CONTR. Prime Drlg.

POOL SW Boggs

SPUD 12-17-57

8'294/225

0343.5

JAN 21 1945

DS7 4604-49

30" $9\frac{1}{2}$ " ga

2.000 mil 15"

ga 3. 600 mm x 134" res

60' gem F P 48c - 795

BHP 1175-1150/30" run

log JAN 8 '58 ran log 5' 46481/58

$150 / 4613 \frac{1}{2} - 43 \frac{1}{2} \frac{1}{2}$ has

30 x 30 184.55 51 24 hrs CaO/Flo

Qa 9.500 mcf SIP 1104

thru tbg NT

80

USE

NO

5
7
9

TW/P

RGE

CO. Barber ELEV. _____SEC. 6 TWP. 34 RGE. 12WCOMPANY Bachus Oil NO. 1

FIRST REPORT

DEC 18 57

FARM McCracken "B"LOC. C NW NE

GEOL. _____

CONTR. Prime Drlg.POOL SW BoggsSPUD 12-17-57

CO.

LSE.

NO.

SEC.

TWP.

RGE.