


Section 6 Township 34 Range 12 W

Well No. #1 Donovan "B"

Company Aylward & Skelly

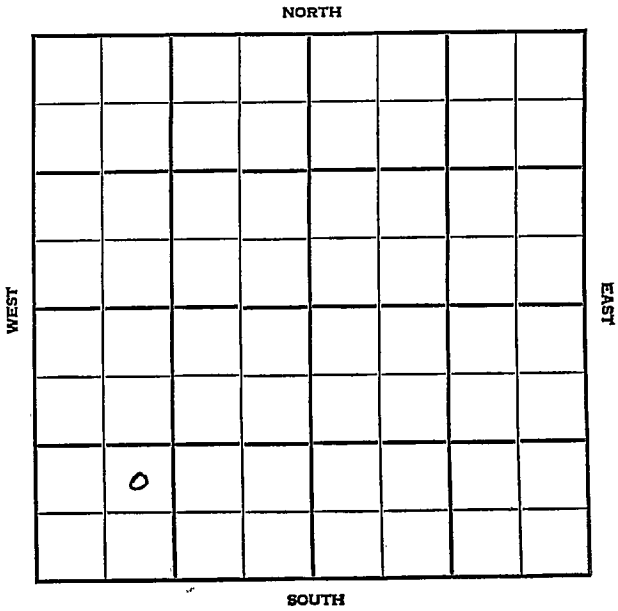

SEC. 6-	TWP. 34	R. 12W
------------	------------	-----------

WELL NO. #1 Donovan "B" FARM

COMPANY Aylward & Skelly

CONTRACTOR Co. Tools

Driftwood Gas


_____ Ft. from N. Line

_____ Ft. from S. Line

_____ Ft. from E. Line

_____ Ft. from W. Line

NE SW SW

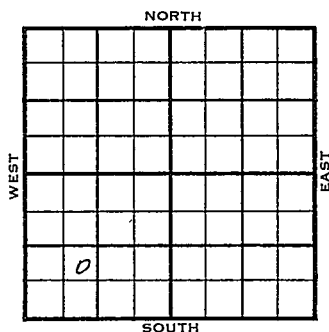

1956 ELEVATION 1555 REPORT

2-22 RUR

3-21 Comm. 2-22-56

8 5/8" @ 190

DST 4660-90 op 1 hr. gas in 3 min,
1890 mcfg, 1690#

DST 4690-4723 op 45 min, gas in 1 min,
3970 mcfg rec. 30' gcm, 1720#

5 1/2" @ 4723

CO 138/ 4678-4705, frac

F/ 8220 mcfg

Comp. open flow 24,500 mcfgpd

Elg. 3600

H. 3788- 3796

L. 3998

M. 4667

TD 4723'

COMPLETED

County Barber Elev. 1555
 Sec. 6 Twp. 34 Rgs. 12W
 Company Aylward & Skelly
 FarmName Donovan "B" No. 1

TOPS	DEPTH	LOG	DATUM	Loc. in Sec.
Anh. <u>E 19'</u>	<u>3600</u>			<u>NE SW SW</u>
Tr.				
H.	<u>3788</u>	<u>3796</u>	<u>2241</u>	
Tr.				
Dg.				
Bl.				
L.		<u>3998</u>	<u>2443</u>	Geol. _____
K.C.				Contr. _____
B.K.C.				Co. tools _____
Ce.				Pool _____
C.				Driftwood Gas _____
M.	<u>4667</u>		<u>3112</u>	
M.				
K.				
Mz.				
Mq.				
V.				
S.				
S.				
A.				
R.				
Pe.				
G.				
T.D.	<u>4723</u>			

COMPLETE

Date Comm. 2-22-56 MAR 2 1 19568 5/8" @ 190 DST 4660-90 open 1 hr.gas in 3 min. 1,890 mcfg 1690#DST 4690-4723 open 45 min. gas in1 min. 3,970 mcfg rec. 30' gcm 1720#5 1/2" @ 4723 CO 138/ 4678-4705frac F/ 8,220 mcfgComp. open flow 24,500 mcfgpd

APR 2 1956

R. G.

County Barber Elev. _____
 Sec. 6 Twp. 34 Rgs. 12W
 Company Ayward & Skelly
 Farm Name Donovan #B No. 1

TOPS	DEPTH	LOG	DATUM	Loc. in Sec.
Anh.				NE SW SW
Tr.				
H.				
Tr.				
Dg.				
Bl.				
L.				Geol. _____
K.C.				Contr. _____
B.K.C.				Co. tools
Ce.				
C.				Pool
M.				Driftwood Gas
M.				
K.				
Mz.				
Me.				
V.				
S.				
S.				
A.				
R.				
PE.				
G.				
T.D.				

FIRST REPORT
 FEB 22 55

Date Comm.
 R U R

2/26

Co.
 Lse.
 No.
 Sec.
 T.
 R.

FEB 27 1956

R. G.