


Section 6 Township 34 Range 4 W

Well No. # 1 E. J. Misak

Company Skelly Oil

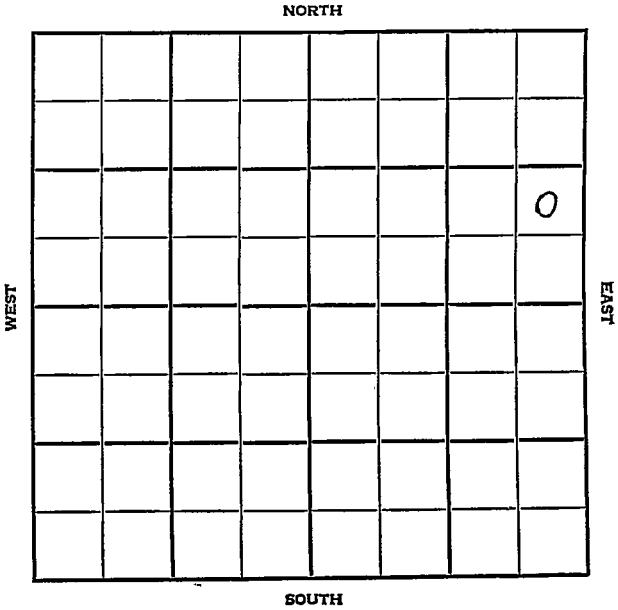

Summer

KANSAS

SEC.	TWP.	R.
6	34	4 W

WELL NO.

#1 E. J. Misak

FARM

COMPANY

Skelly Oil

CONTRACTOR

Hulme

Gerberding Pool


\_\_\_\_\_ Ft. from N. Line

990 \_\_\_\_\_ Ft. from S. Line

330 \_\_\_\_\_ Ft. from E. Line

\_\_\_\_\_ Ft. from W. Line

NE SE NE

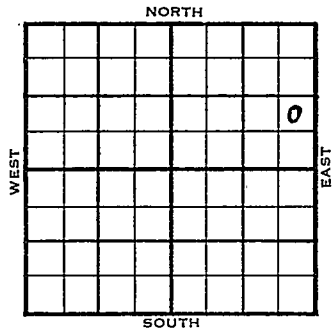

	ELEVATION	REPORT
1955	1241'	
1/26	Location	
3/30	Spud 2-5-55 Oil well TD 4960' 8" @ 318 KC 3618 DST 3595-3685 open 1 hr rec 200' HGCM 60' HGCWM, 240' HO & GCWM 1469# B KC 3858' Marm 3950 Miss 4305 DST 4294-4330 open 1 hr rec 50' mud 430# Kh. 4644 Chattanooga 4700 Simp. 4726 DST 4729-79 open 1 hr rec 360' gas, 40' OCM, 5' free oil, 1645# Arb. 4938' TD 4960 5" @ 4960 CO to 4925' 95/4872-88 B/1 GWPB 6 hr. 500 A S/10 BAW 7 hr. PB 4800 54/4733-42 B/1/2 GWPB 2 hr. <del>205</del> 250 A S/15 GWPB 7 hr. sd-oil-frac. S/45 BO 40 BW 13 hr. S/32 BO 13 BW 4 hrs. S/64 BO 17 BW 6 hr. S/60 BO 20 BW 250,000 CFG 16 hr. Comp. 120 BOPD 26 BW	
	<b>COMPLETED</b>	

County Sumner State Kansas

Sec. 6 (Blk.) 34 (Sur.) 4W Map No.

Operator Skelly Oil

Well No. 1 Farm E. J. Misak

Elev. 1241 Location NE SE NE


990 Ft. From S Line NE

330 Ft. From E Line Quarter

1st. Report

Completion MAR 30 1955

Remarks Gerberding Pool

Hulme - Contr.

Spudding Date 2-5-55

Drig. Data Oil well TD 4960

8" @ 318 KC 3618 DST 3595-3685

open 1 hr. Rec. 200' hgcm 60' hgcwm

240' ho & gcwm. 1469# B KC 3858

Marm. 3950 Miss. 4305 DST 4294-4330

open 1 hr. Rec. 50' mud 430#

Kh. 4644 Chattanooga 4700 Simp/ 4726

DST 4729-79 open 1 hr. Rec. 360' gas

40' ocm 5' free oil 1645# Arb. 4938

TD 4960 5" @ 4960 CO to 4925

95/ 4872-88 B/ 1 gwph 6 hr. 500 A

S/ 10 baw 7 hr. PB 4800 54/ 4733-42

B/ 1/2 gwph 2 hr. 250 A S/ 15 gwph

7 hr. sd-oil-frac S/ 45 bo 40 bw

13 hr. S/ 32 bo 13 bw 4 hr.

**OVER**  
**FABEN GILSTRAP**

Drig. Data

S/ 64 bo 17 bw 6 hr. S/ 60 bo 20 bw

250,000 cfg 16 hr.

Comp. 120 bopd

26 bw

MISC

FIELD MAPS

FIELD MAPS

FIELD MAPS

LAND WASH MAPS

LAND SURVEY MAPS

SCOUT CARDS

APR 1 1955

