


Section 6 Township 34 Range 13W

Well No. #1 Ott

Company K&E Drlg.

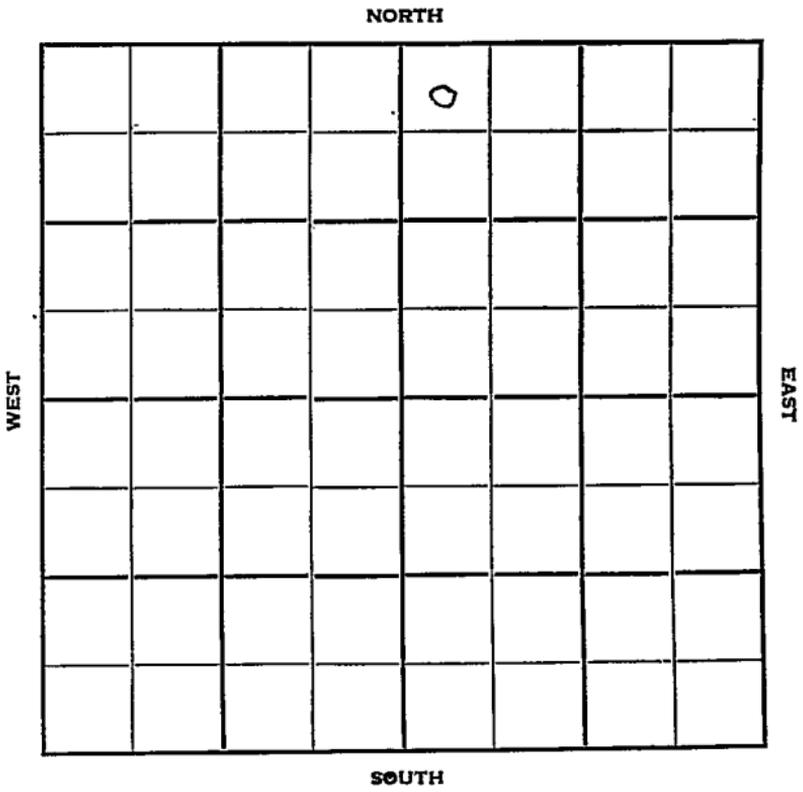

Sec. 6 Twp. 34 R. 13W

Well No. #1 6tt Farm

K & E Drlg. Company

K & E Drlg. Contractor


Wildcat

330 Ft. from N. Line

_____ Ft. from S. Line

_____ Ft. from E. Line

330 Ft. from W. Line

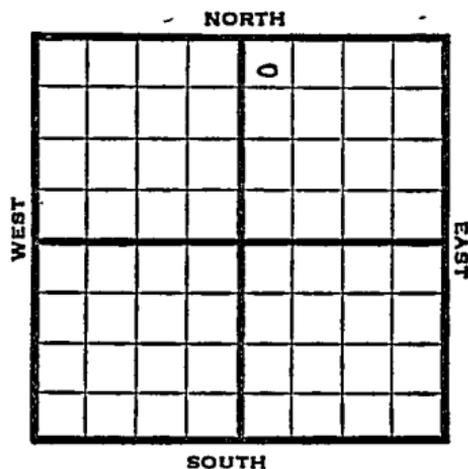

NW NE NE

Superior FO

1952	Elev. 1876'	REPORT
2/20	Spud 2-12-52 8" @ 352'	Drlg. 3045'
3/5	Drlg. 4865'	
3/12	Miss 4865 45' M 210#	DST 4857-4930 1/2 hr. DST 4956-75' 1/2 hr. 25' M 900# KH 4987 V 5188 Drlg. 5268'
3/19	Spud 2-12-52 D & A TD 5502' 8" @ 352'	Elgin sand 3971' Lans. 4284' Miss 4865' DST 4857-4930 open 1/2 hr. rec 45' mud DST 4956-75 open 1/2 hr. rec 25' mud Kh. 4987' Viola 5188' Simp. 5307' DST 5191-5203 open 1 hr. rec 1500' SW TD 5502' D & A

ABANDONED

County **Barber** State **Kansas**

Sec. **6** (Blk. Twp.) **34** (Sur. Rge.) **13W** Map No.

Operator **K & E Drlg.**

Well No. **1** Farm **Ott**

Elev. Location **NW NW NE**

		0		
/	/		/	/
/	/		/	/
FIRST REPORT				
/	/		/	/
/	/		/	/

330 Ft. From **N** Line **NE**

330 Ft. From **W** Line **Quarter**

Ist. Report **FEB 20 1952**

Completion

Remarks **Superior ^{ferment} support**

K & E Drlg. - Contr.

Spudding Date **2-12-52**

Drlg. Data **Wildcat**

8" @ 352 drlg. 3045

J. G. McGEHEE


County Barber State Kansas

Sec. 6 (Blk.) 34 (Sur. Rge.) 13W Map No.

Operator K & E Drlg.

Well No. 1 Farm Ott

Elev. 1876 Location NW NW NE

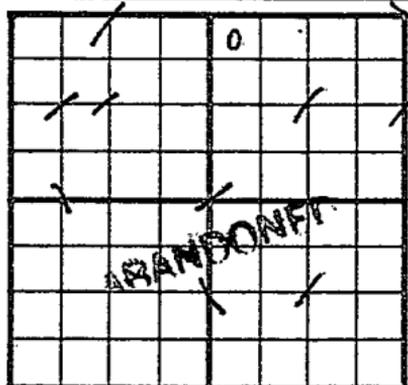

330 Ft. From N Line NE

330 Ft. From W Line Quarter

Ist. Report

Completion MAR 19 1952

Remarks Wildcat

K & E Drlg. - Contr.

Spudding Date 2-12-52

Drlg. Data D & A TD 5502

8" @ 352 Elgin sand 3971 Lans. 4284

Miss. 4865 DST 4857- 4930 open 1/2 hr.

Rec. 45' mud DST 4956-75 open 1/2 hr.

Rec. 25' mud Kh. 4987 Viola 5188

Simp. 5307 DST 5191-5203 open 1 hr.

Rec. 1500' sw TD 5502

D & A