


Section 6 Township 34 Range 33-W

Well No. #1 Fincham

Company Cities Service

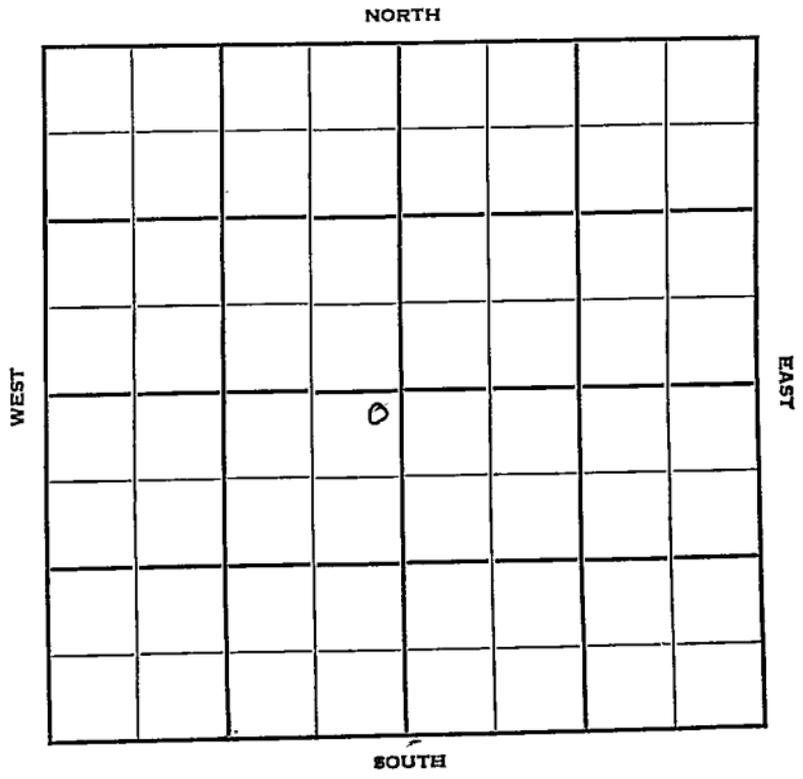

Sec. 6 Twp. 34 R. 33W

Well No. #1 Fincham Farm

Cities Service Company

Barbour Drlg. Contractor

Hugoton Pool


100' Ft. from N. Line

Ft. from S. Line

100' Ft. from E. Line

Ft. from W. Line

NE SW

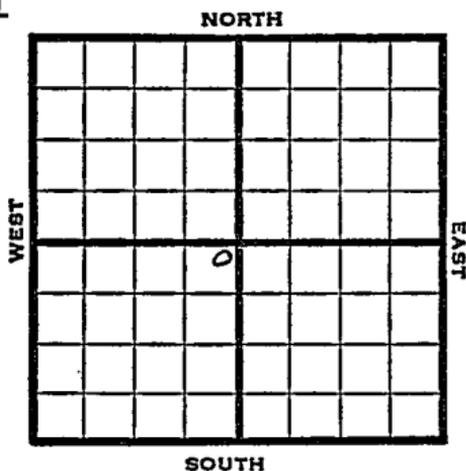

1950

Elev 2869' REPORT

9/6

MIM

12/20

Spud 9-5-50

8" @ 600

TD 2775

5" @ 2775

Her 2602

Krider 2630

Win 2719

120/2660-84 60/2630-36 40/2606-10

8500 A

sq off

CO to 2683 80/2660-76

50/2628-38 40/2602-10

12500 A

Comp 8,520,000 gas

Completed

COMPLETED

Scout Cards

Land Small Map

Land Wall Map

Tracings

France Map

Diana Men

Misc.

SEP 3 1950

Scout Cards	7 w
Land Small Map	
Land Wall Map	3
Tracings	
Frame Map	
Pierce Map	
Misc.	

DEC 27 1950

Orig. Data