


KANSAS

Section 6 Township 34 Range 34-W

Well No. #1 Buboia

Company Plains Natural Gas

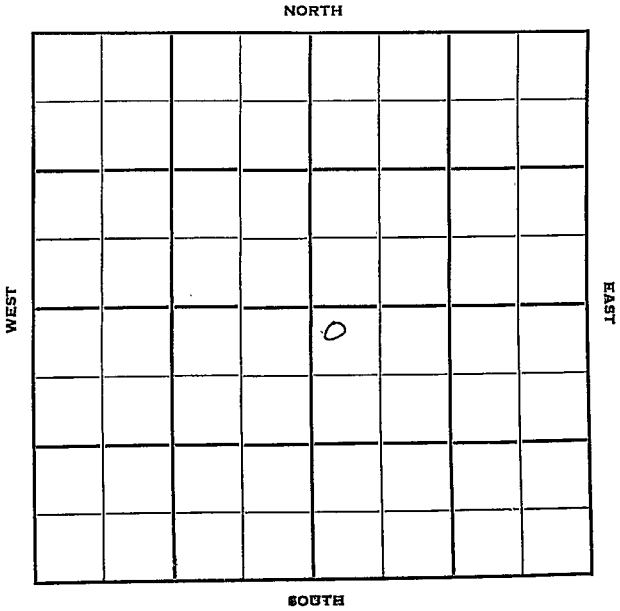

Sec. 6 Twp. 34 R. 34W

Well No. #1 Buboiss Farm

Plains Natural Gas Company

Contractor \_\_\_\_\_

Hugoton Pool


200' Ft. from N. Line

\_\_\_\_\_ Ft. from S. Line

\_\_\_\_\_ Ft. from E. Line

200' Ft. from W. Line

NW SE

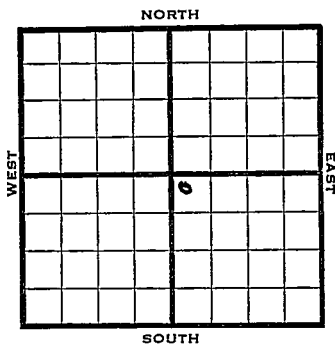

Gas Well

1950

Elev 2941 REPORT

8/23 Location

10/11 Spud 9-9-50

10" @ 688

7" @ 277

TD 2779

Hol 2587

Her 2650

Krider 2684

Win 2763

CO to 2757

240/2712-52, 48/2699-2704, 36/2786-92

60/2660-70, 30/2652-57, 60/2765-75

16000 total acid

Comp 1,949,000 gas Del test

Completed

**COMPLETED**



