

KANSAS


Stevens

FORM 51 5M BR1X

Section 6 Township 34 Range 36W

Well No. #1 Albritten

Company Republic Nat. Gas

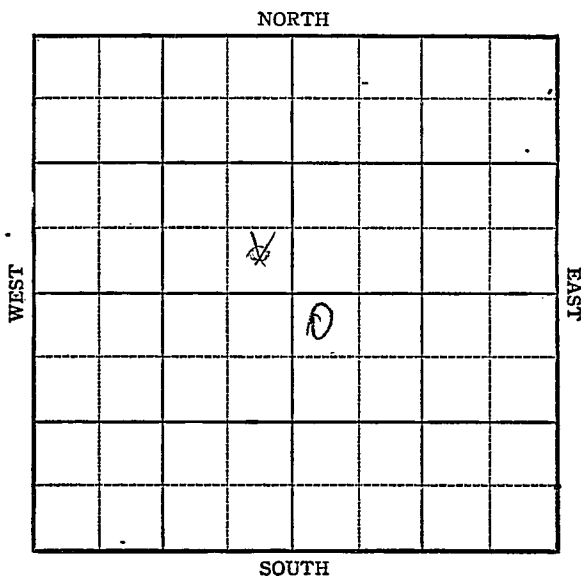

KANSAS

Stevens County

Sec. 6 Twp. 34 R. 36W

Well No. #1 Albritten Farm

Republic Nat Gas Company


Hugoton

300 Ft. from N. Line

Ft. from S. Line

Ft. from E. Line

300 Ft. from W. Line

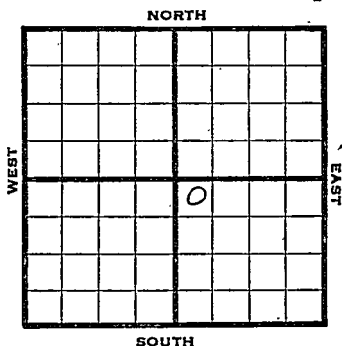

NW SE

1944 Elev. 3077 R E P O R T

12/13 Location

12/21 "

12/29 "

1945
1/3 "

1/10 "

1/17 R U R

1/26 10" @ 668' WOC

1/31 Drlg. 2215'

2/7 7" @ 2666 RUST

2/14 " " " "

2/21 " " " "

2/28 " " " "

3/7 " " " "

3/14 " " " "

3/23 " " " "

3/29 " " " "

4/5 " " " "

4/12 " " " "

4/20 Drlg. 2675'

4/27 TD 2780

12 M Gas

OVER

1945

5/9

7" @ 2666

8000 acid.

TD 2780'

28,626,000 Gas

COMPLETED

Pool Name HugotonMap No. NM Sec. 6 Twp. 34 R. 36WWell No. 1 AlbrittenRepublic Nat Gas Company**FIRST REPORT**

Contractor

NW SE**SECTION PLAT**300 Ft. from N. Line Ft. from S. Line Ft. from E. Line300 Ft. from W. Line

		o	

StevensLocation XRig up

Drilling and Remarks:

RECORDCased in., ft.Sand Gas Oil Total Depth **PRODUCTION**1st 24 hrs. Nat. 1st 24 hrs. after shot Gas Cu. Ft.Dry Hole Abandoned

Date

DEC 13 1944

19

S. J. LEWIS

Scout

no world maps


Misc. Small Maps	<i>LR</i>
Cards	<i>Little</i>
Tracing	
France Map	
Scarborough Map	<i>LR</i>
Locdy Map	
Geological Dept.	
Moody Plat Book	

Kansas Pool Name HugotonMap No. no map Sec. 6 Twp. 34 R. 36WWell No. 1 Albritten TrusteesRepublic Nat. Gas Company

COMPLETED

Contractor

NW SE

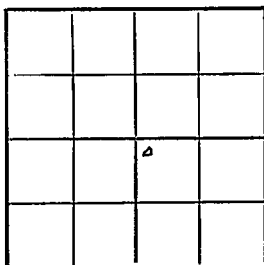E13072
SECTION PLAT300 Ft. from N. Line Ft. from S. Line Ft. from E. Line300 Ft. from W. LineStevens County

RECORD

Location Cased in., ft.Rig up Sand

Drilling and Remarks:

Gas Oil Total Depth 2700

PRODUCTION

1st 24 hrs. Nat. 1st 24 hrs. after shot Gas Cu. Ft.Dry Hole Abandoned

Date

MAY 9 1945 19

S. J. LEWIS

Scout

no wall.

Misc. Small Maps

Cards

Tracing

France Map

Scarborough Map

Pierce Map

Geological Depts.

Pierce Map