


Section 6 Township 34 Range 12W

Well No. #1 Interstate

Company Panhandle Eastern

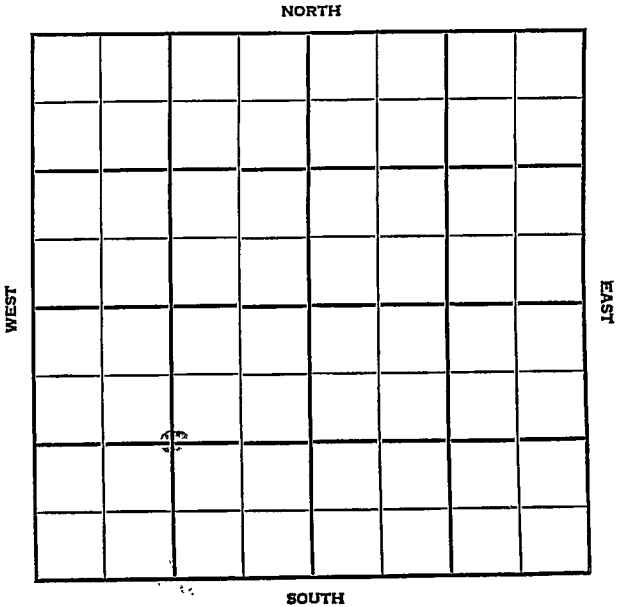

Morton

KANSAS

SEC.

6

TWP.

34

R.

B2W

WELL NO.

#1 Interstate

FARM

COMPANY

Panhandle Eastern

CONTRACTOR

Falcon-Seaboard

Greenwood


_____ Ft. from N. Line

_____ Ft. from S. Line

_____ Ft. from E. Line

_____ Ft. from W. Line

C SW/4

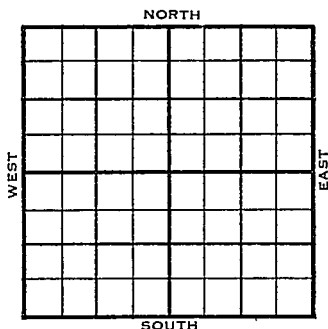

1955

ELEVATION

REPORT

6/1

Comm. 4-29-55

10" @ 606/325 7" @ 3101/300 CO

20/3053-58 1000 A 500,000 cfg

3000 A SP 3045 36/3024-34

800,000 cfg 10 gwph 2000 A

800,000 cfg 3 bwph SP 3002

24/2976-82 1000 A 3000 A 603mcfg

50 gwph CO 80/2896-2916 1000 A

20/2859-64 44/2835-46 60/2804-19

Comp. 8,873 mcfgpd 412#

Anh. Log 2557

Tp. " 2774

TD.

Depth: 3110

FIRST REPORT

COMPLETED

County Morton Elev. _____
 Sec. 6 Twp. 34 Rge. 42W
 Company Panhandle Eastern
 Farm Name Interstate No. 1

TOPS	DEPTH	LOG	DATUM	Loc. in Sec.
Anh. <u>Waub</u>		<u>2557</u>		<u>C SW/4</u>
Tr.		<u>2774</u>		
H.				<u>1320' SL</u>
Dg.				<u>1280' WL</u>
BL.				
L.		<u>3017</u>		Geol. _____
K.C.				Contr. _____
B.K.C.				<u>Falcon-Seaboard</u>
Ce.				Pool _____
C.				<u>Greenwood</u>
M.				
M.				
K.				
Mz.				
Me.				
V.				
S.				
S.				
A.				
R.				
Pe.				
G.				
TR.	<u>3110</u>			

FIRST REPORT
COMPLETE

Date Comm. 4-29-55 JUN 1 1955

10" @ 606/325 7" @ 3101/300 CO

20/ 3053-58 1000 A 500,000 cfg

3000 A SP 3045 36/ 3024-34

800,000 cfg 10 gwph 2000 A

800,000 cfg 3 bwph SP 3002

24/ 2976-82 1000 A 3000 A 603 mcfg

50 gwph CO 80/ 2896-2916 1000 A

20/ 2859-64 44/ 2835-46 60/ 2804-19

Comp. 8,873 mcf gpd 412#