


Morton

Form 51-5M-2-29-34703

Map No. KANSAS Sec. 6 Twp. 34 R. 39

Well No. 1- Mangels Farm
Argus Gas Company

NORTH

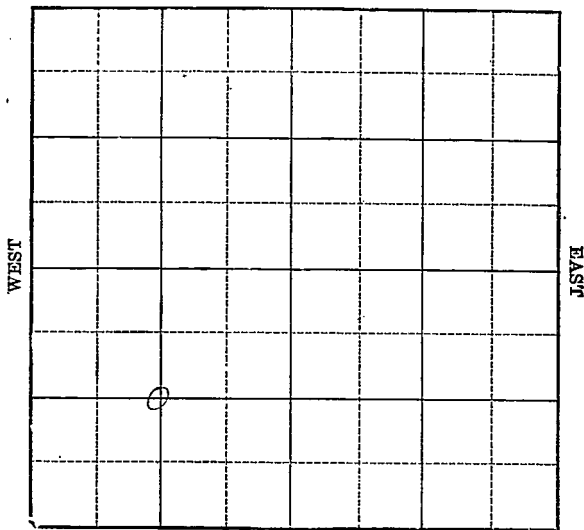

SOUTH

Location

Drilling Remarks

Rig Up

Drilling Remarks

RECORD

Cased in. ft.

Sand

Gas

Oil

Total Depth

PRODUCTION

1st 24 hrs. Nat.

1st 24 hrs. after shot

Gas cu. ft.

Dry Hole

Abandoned

Map No. KANSAS Sec. 6 Twp. 34 R. 39^W
Well No. 1- Mangels Farm
Argus Gas Company

NORTH


_____ Ft. from N. Line

1320 Ft. from S. Line

_____ Ft. from E. Line

1320 Ft. from W. Line

1930

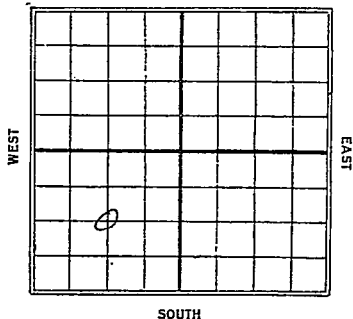

Date

REPORT

4/30	Loc.
5/7	Rig
5/14	Rigging up
5/21	hdlg. 1231'
5/28	" 2300'
6/4	S.D. 2510'
6/11	Quest 2521'
6/18	Land 2521-2900
	TD 2900
	3-M Gas
	Comp.


Map No. Morton **KANSAS** Sec. 6 Twp. 34 R. 39W

Well No. 1 Mangels

Argus Gas Company

Contractor

SECTION PLAT

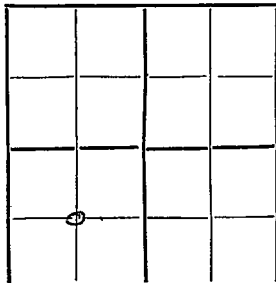

.....Ft. from N. Line

1320 Ft. from S. Line

.....Ft. from E. Line

1320 Ft. from W. Line

FIRST REPORTS

Location ✓

Rig up

Drilling and Remarks:

RECORD

Cased in., ft.

Sand

Gas

Oil

Total Depth

PRODUCTION

1st 24 hrs. Nat.

1st 24 hrs. after shot

Gas Cu. Ft.

Dry Hole

Abandoned

Date

APR 30 1930

S. J. LEWIS Scout


Map No. KANSAS Sec. 6 Twp. 34 R. 39 W

Well No. 1 Mangle

August Gas. Company

Contractor

SECTION PLAT

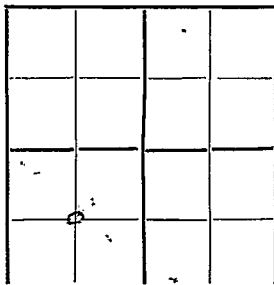

.....Ft. from N. Line

1320 Ft. from S. Line

.....Ft. from E. Line

1320 Ft. from W. Line

COMPLETED

Location.....

Rig up.....

Drilling and Remarks:

3 M Gas

RECORD

Cased.....in.,ft.

Sand 2521 - 2900

Gas.....

Oil.....

Total Depth 2900

PRODUCTION

1st 24 hrs. Nat.....

1st 24 hrs. after shot.....

Gas.....Cu. Ft.

Dry Hole.....

Abandoned.....

Date

JUN 18 1930 192 S. J. LEWIS Scout