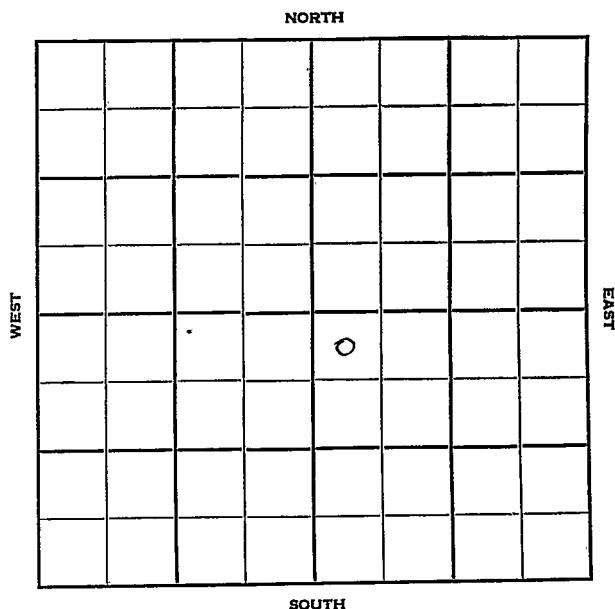


Section 6 Township 34 Range 40WWell No. #1 Bahn "B"Company Cities Service

Morton

KANSAS

Sec. 6 Twp. 34 R. 40W

Well No. #1 Bahn "B" Farm

Cities Service

Company

Contractor

Hugoton Pool


100' Ft. from N. Line

Ft. from S. Line

Ft. from E. Line

100' Ft. from W. Line

NW SE

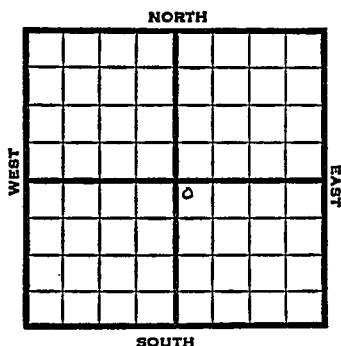

1951

Elev. 3364' REPORT

5/2

Location

6/13

Spud 5-3-51

Gas Well TD 2450

8" @ 398 Kri 2320

Win 2386

TD 2450 5" @ 2449 80/2402-18

60/2386-98 60/2352-64

140/2316-44 23,000 A

Comp. 10,700,000 gas

COMPLETED

J. E. TYRA

County Morton State Kansas

Sec. 6 (Blk. Twp.) 34 (Sur. Rge.) 40W Map No.

Operator Cities Service

Well No. 1 Farm Bahn "B"

Elev. 3364 Location NW SE


100 Ft. From N Line SE

100 Ft. From W Line Quarter

1st. Report _____

Completion JUN 13 1951

Remarks Hugoton Pool

Spudding Date 5-3-51

Drig. Data	Gas well	TD 2450
------------	----------	---------

8" @ 398 Kri. 2320 Win. 2386

TD 2450 5" @ 2449 80/ 2402-18

60/ 2386-98 60/ 2352-64

140/ 2316-44 23000 A

Comp. 10,700,000 gas

J. E. TYRA