

Harper

KANSAS

SEC. 16	TWP. 34	R. 7W
---------	---------	-------


WELL NO. #1 Cather FARM

COMPANY J.M. Huber

CONTRACTOR G-M-R

WILDCAT

\_\_\_\_\_ Ft. from N. Line  
 \_\_\_\_\_ Ft. from S. Line  
 \_\_\_\_\_ Ft. from E. Line  
 \_\_\_\_\_ Ft. from W. Line

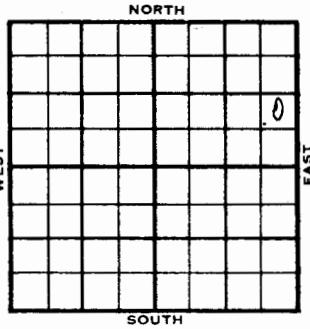

NE SE NE

Continental FO

1955	ELEVATION 1402	REPORT
------	----------------	--------

12-28 Comm. 12-27-55

1956

1-25 8 5/8" @ 317/250  
 DST 3845-53 op 45 min. rec. 1975' gcsw  
 1620/15"  
 D & A  
 Tp. 3045  
 LeComp. 3235  
 Heeb. 3365  
 Leavan 3375  
 Tor. 3515  
 Stal. 3843-3842  
 Stal Sd. 3877  
 KC 4082-4082  
 Marm 4400  
 Ft. Schtt 4515  
 Ce lime 4531  
 Ce Sh. 4566  
 Miss ch. 4690-4697  
 Miss. lm. 4710  
 Kh sh. 5033  
 Chatta 5122- 5118  
 Viola 5150 - 5151  
 Simp. 5182-5175  
 A. 5393  
 TD 5451'

**ABANDONED**

DX-78

FORM 513 REV. SUNRAY

County	Harper	Elev.	1402
Sec.	16	Twp.	34
		Rgs.	7W
Company	J. M. Huber		
Farm Name	Cather	No.	1

TOPS	DEPTH	LOG	DATUM	Loc. in Sec.
Anh				NE SE NE
Tp.	3045		1643	
H. LeComp	3235		1833	
Tr. Heeb	3365		1963	
Dg. Leavan	3375		1973	
Bl. Tor.	3515		2113	
L. Stal	3843	3842	2440	
K.C. " Sd	3877		2475	Geol.
B.K.C. KC	4082	4082	2680	
Ce. Marm	4400		2998	Contr
C. Ft Schtt	4515		3113	G-M-R
M. Ce lime	4531		3129	
M. " Sd	4566		3164	Pool
K. Miss ch	4690	4697	3295	Wildcat
Mz. " lm	4710		3388	
Mo. Kh sh	5033		3631	
V. Chatta	5122	5118	3716	
S. Viola	5150	5151	3749	
S. Simp	5182	5175	3773	
A.		5393	3991	
R.				
PE.				
G.				
TD	5451			

Date Comm. 12-27-55 JAN 25 1956

8 5/8" @ 317/250 DST 3845-53  
 open 45 min. rec. 1975' gcsw  
 1620/15"

D & A

