

Harper

SEC. 35 TWP. 34 R. KANSAS
7W


WELL NO. **1 Sallie Carr** FARM

COMPANY **C. H. Nicholson (Tulsa)**

CONTRACTOR **Irion Drlg**

Wildcat

_____ Ft. from N. Line
 _____ Ft. from S. Line
 _____ Ft. from E. Line
 _____ Ft. from W. Line

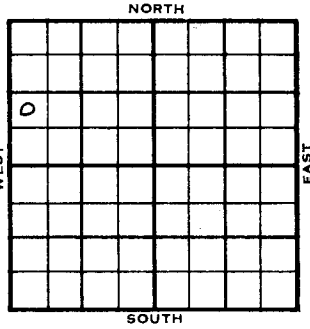

NW SW NW

1955 ELEVATION **1398** REPORT

5/26 Comm 5-4-55
 H 3560; L 4110; M 4765;
 8" @ 250
 Oread 3515; Stal 3880;
 Drlg 4785

6/1 Comm 5-4-55
 Anh 1580, Tp Oread 3515, H 3560,
 Dg Stal 3880, L 4110, BKC Marm 4440
 Ce 4610, M 4765, Woodford 5225,
 V 5249, S Sd 5306 A 5512
 TD 5562
 8" @ 250
 DST 5305-13 open 1 hr Rec 210' mud
 4300' sw D&A

ABANDONED

FORM 513 REV. SUNRAY

County Harper Elev. 1398
 Sec. 35 Twp. 34 Rge. 7W
 Company C. H. Nicholson (Tulsa)
 FarmName Sallie Carr No. 1

TOPS	DEPTH	LOG	DATUM	Loc. in Sec.
Anh	1580		182	NW SW NW
Tp. Oread	3515		2117	
H.	3560		2162	
Tr.				
Dg. Stal.	3880		2482	
Bl.				
L.	4110		2712	Geol.
K.C.				Contr.
B.K.C. Marm	4440		3042	Iron Drlg.
Ce.	4610		3212	
C.				
M.	4765		3367	Pool
M.				Wildcat
W. Woodford	5225		3827	
Mz.				
Mo.				
V.	5249		3951	
S. Sd	5306		3908	
S.				
A.	5512		4114	
R.				
PE.				
G.				
TD.	5562			

ABANDONED

Date Comm. 5-4-55 **JUN '1 1955**

8" @ 250 DST 5305-13 open 1 hr.

Rec. 210' mud 4300' sw

D & A