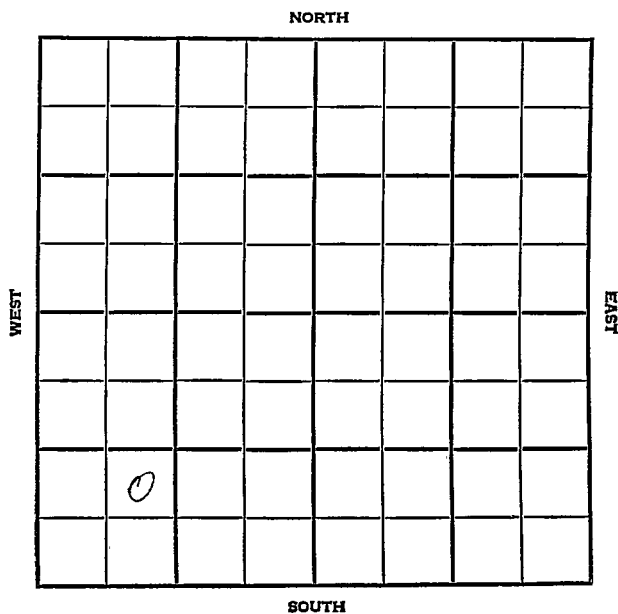


Section 7 Township 34 Range 12WWell No. #1 V. L. CookCompany Magnolia Pet.

Barber

KANSAS

SEC.	TWP.	R.
7	34	12W

WELL NO.

#1 V.L. Cook

FARM

COMPANY

Magnolia Petr.

CONTRACTOR

Aylward

Driftwood

____ FT. FROM N. LINE

____ FT. FROM S. LINE

____ FT. FROM E. LINE

____ FT. FROM W. LINE

NE SW SW

NORTH

WEST

EAST

SOUTH

1956

ELEVATION

REPORT

8-22

Location

County Barber Elev. 151
 Sec. 7- Twp. 34 Rge. 12W
 Company Magnolia Pet.
 Farm Name W. L. Cook No. 1

TOPS	DEPTH	LOG	DATUM	Loc. in Sec.
Anb. <u>E198d</u>		<u>3700</u>		NE SW SW
Tr.				
H.	<u>3896</u>	<u>3895</u>		
Tr.				
Dg.	<u>3970</u>	<u>3963</u>		
Bl.				
L.	<u>4096</u>	<u>4093</u>		
K.C.				Geol.
B.K.C.				Contr.
Ce.				<u>Award</u>
C.				Pool
M.	<u>4789</u>	<u>4773</u>		<u>Driftwood</u>
M. <u>chat</u>	<u>4817</u>	<u>4814</u>		
K.				
Mz.				
Mo.				
V.				
S.				
S.				
A.				
R.				
PE.				
G.				
TD.	<u>4890</u>			

COMPLETE

OCT 3 '56

Date Comm.

Location AUG 29 '56 ✓ SEP 5 '56 8-31-
56 85/8 340 / 275 D 2012 SEP 12 '56
D. 3967 SEP 19 '56 DST 4817-27
ex 2 hrs G/3" ga 2,830 MCF
nee 30' GCM BHP 1760 / 20"
DST 4828-60 1 hr G/1" ga 1,450
M/5" 3,120 M/30" stabil. nee
30' HECM BHP 1740 / 20" Rn 9
Log SEP 26 '56 5 1/2 @ 4889 / 200 DST 3 '56

CO 4865 192/4818-50 Frac

25 X 25 F/g Ld + 4.735

MLFG

SET 3 54

CALOP F/W

11.500 MCF SIPP 1570

SICP 1584 BHP 1774

County Barber Elev. _____
 Sec. 7 Twp. 34 Rge. 12W
 Company Magnolia Pet.
 Farm Name V. L. Cook No. 1

TOPS	DEPTH	LOG	DATUM	Loc. in Sec.
Anh.				NE SW SW
Tr.				
H.				
Tr.				
Dg.				
BL.				
L.				Geol.
K.C.				Contr.
BK.C.				Ayward
Ce.				
C.				Pool
M.				Driftwood
M.				
K.				
Mz.				
Mo.				
V.				
S.				
S.				
A.				
R.				
Pe.				
G.				
T.D.				

FIRST REPORT			

Date Comm. AUG 22 '56

Location

272 S 31A

26