


SECTION 7 TOWNSHIP 34 RANGE 25W

WELL NO. #1 Theis "C"

COMPANY Graham-Michaelis

NORTH

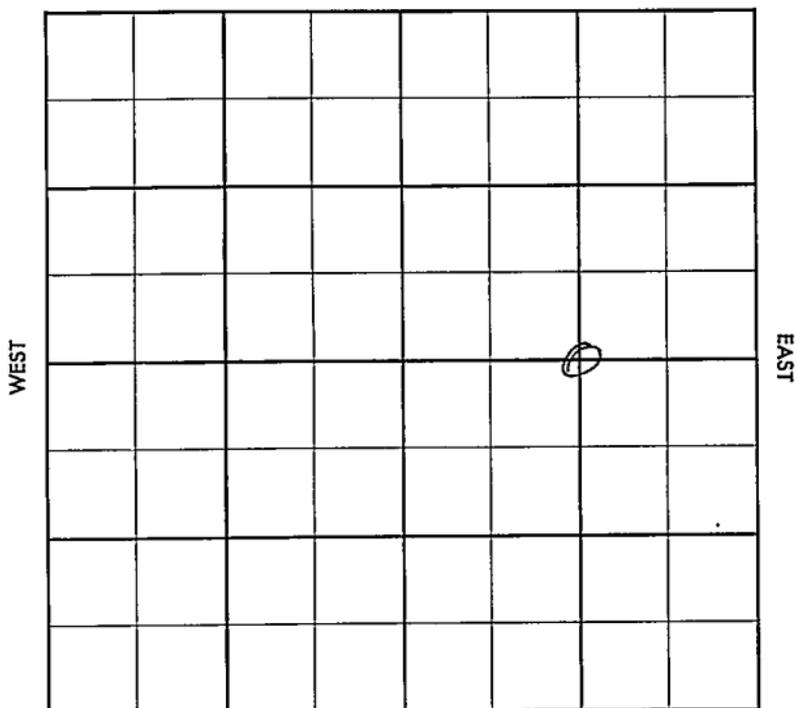

SOUTH

County Clark Elev. _____
 Sec. 7 Twp. 34 Rgs. 25W
 Company Graham-Michaelis
 Farm Name Theis "G" No. 1

TOPS	DEPTH	LOG	DATUM	Loc. in Sec.
Anh.				<u>0 E¹/₂</u>
Tp.				
H.				
Tr.				
Dg.				
Bl.				
L.				Geol. _____
K.C.				Contr. _____
B.K.C.				<u>Co. tools</u>
Ce.				Pool _____
C.				<u>McKinney</u>
M.				
M.				
K.				
Mz.				
Mo.				
V.				
S.				
S.				
A.				
R.				
PE.				
G.				
T.D.				

FIRST REPORT
 JAN 16 47

Date Comm. RUR

~~24~~

Co.

Lse.

No.

Sec.

T.

R.

5638
2156

-3482

FORM 513, SUNRAY

County Clark Elev. 2156 DF
 Sec. 7 Twp. 34 Rge. 25W
 Company Graham-Michaelis
 Farm Name Theis "C" No. 1

TOPS	DEPTH	LOG	DATUM
Anb.			
TP.			
H.			
Tr.			
Dg.			
Bl.			
L.			
K.C.			
B.K.C.			
Ce. <u>Mush</u>		<u>5620</u>	
C. <u>"sd"</u>		<u>5627</u>	
M. <u>chest</u>		<u>5638</u>	
M.			
K.			
Mz.			
Mo.			
V.			
S.			
S.			
A.			
R.			
PE.			
G.			
TD	<u>5860</u>	<u>5860</u>	

Loc. in Sec. C 1
 Geol. ?
 Contr. Co. tools
 Pool McKinney

COMPLETE
 APR 3 '57

Date Comm. RUR JAN 23 '57 1-16-57 8578
512/350 D. 2781 MAR 10 '57 4830
FEB 6 '57 D. 5685 FEB 13 '57 512 @ 5784
1175 WOCT FEB 20 '57 FEB 27 '57 MAR 6 '57
CO 5760 24/5729-35 1/2 1
no 925 9a. 250 MCF 15 9a
3 Mill. PB 5720 56/5676-90
9a 3 Mill. CFB 10 MAR 13 '57
log @ 5670 pf 12/5657-60

Co.
 Lot
 No.
 Sec.
 T.
 R.

8 / 5644-46 - 500 MCA

CO 5760 SIP / 1100 # MAR 20 '57

MAR 27 '57 est of Flow 6 Mill

CFRPD APR 3 '57

complete ✓