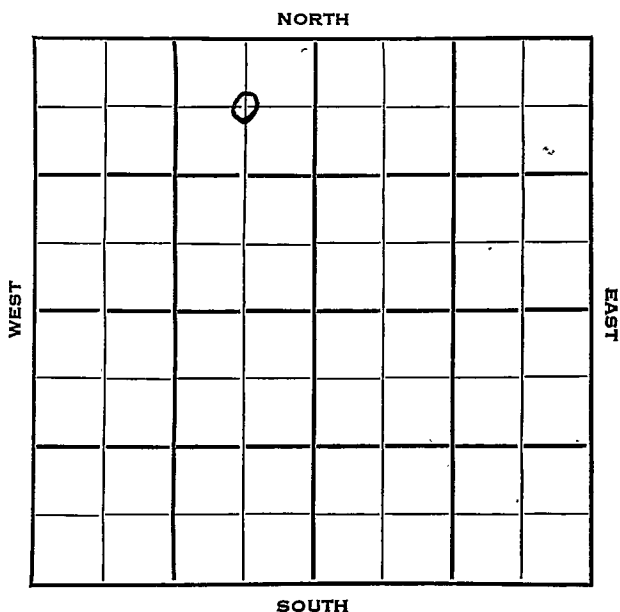


Section 7 Township 34 Range 29 WWell No. # 1 Bromwell-AdamsCompany Huber Corp.

Meade

KANSAS

Sec. 7 Twp. 34 R. 29WWell No. #1 Bromwell-Adams Farm

Huber Corp.

Company

Rine Drlg.

Contractor

Adams Ranch Pool

660


Ft. from N. Line

Ft. from S. Line

660

Ft. from E. Line

Ft. from W. Line

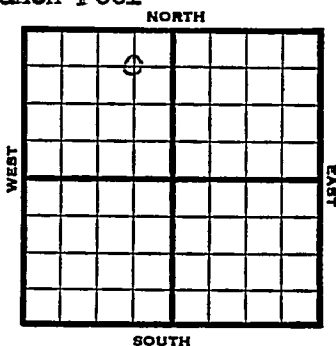C NE NW
Texas F/O

1953

Elev. 2636' REPORT

8/26

Spud 8-21-53

13" @ 625'

Drlg 2100'

9/2

9" @ 2500'

Drlg 3386'

9/9

Drlg.

9/16

Her 2690, Marm 5336,

DST 5279-5380 1 hr, 1140' SW, 1605#

Cherokee 5450, Morrow 5798'

9/23

D & A

9/30

Spud 8-21-53

D & A

TD 6100'

13" @ 625'

Her. 2690,

9" @ 2500'

Win. 2804, Lans 4480, Marm 5336,

DST 5299-5380' opn 1 hr, rec 1140' sw

1605# cherokee 5450, Morrow 5798

DST 5920-95' opn 1 1/4 hr, rec 25' mud 0#

DST 5997'-6097' opn 1 hr, rec 10' mud

0#. Chester 5928

TD 6100'

D & A

ABANDONED

County **Heade** State **Kansas**

Sec. 7 (Blk. 34 (Sur. 29 Map No. 7)
Twp.) Rge.)

Operator **Huber Corp.**

Well No. 7 Farm Bromwell-Adams

[illegible]

2

FIRST REPORT

660 Ft. From N Line TIME

660 Ft. From E Line Quarter

1st. Report **AUG 26 1953**

Completion

Remarks Texas farmout


Rine Drlg. - Contr.

Spudding Date 8-21-53

Drlg. Data Adams Ranch Pool

13" @ 625 drlg. 2100

County Meade State Kansas
 Sec. 7 (Blk. 34) (Sur. 29W) Map No. Map No.
 Operator Huber Corp.
 Well No. 1 Farm Bromwell-Adams
 Elev. 2636 Location C NE NW

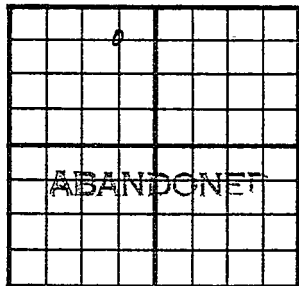

660 Ft. From N Line NW
660 Ft. From E Line Quarter
 Ist. Report
 Completion SEP 30 1953
 Remarks Adams Ranch Pool
Rine Drlg. - Contr.
 Spudding Date 8-21-53

Drlg. Data D & A TD 6100
13" @ 625 Her. 2690 9" @ 2500
Win. 2804 Lans. 4480 Marm. 5336
DST 5299-5380 open 1 hr. Rec. 1140' sw
1603# Cherokee 5450 Morrow 5798
DST 5920-95 open 1½ hr. Rec. 25' mud
0# DST 5997-6097 open 1 hr. Rec. 10'
mud- 0# Chester 5928 TD 6100

D & A