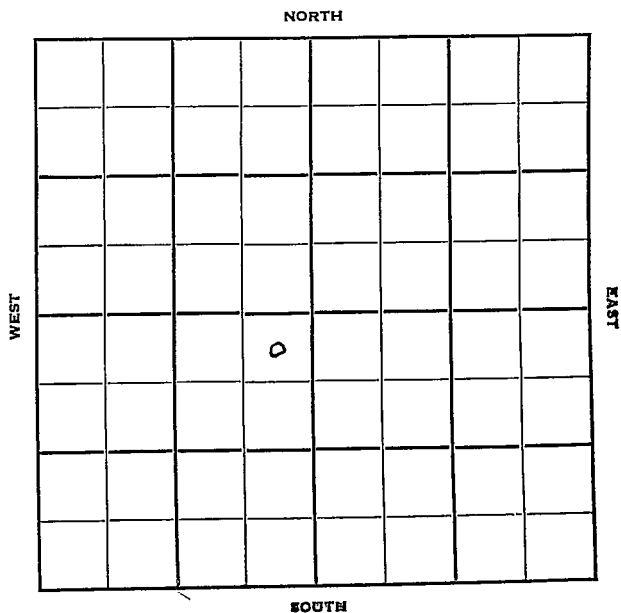


Section 7 Township 34 Range 33WWell No. #1 MetcalfCompany Cabot Carbon

KANSAS  
34

Se ward  
33-W

Sec. 7 Twp. \_\_\_\_\_ R. \_\_\_\_\_

Well No. #1 Metcalf Farm \_\_\_\_\_

Cabot Carbon Company \_\_\_\_\_

Contractor \_\_\_\_\_

Hugoton

330

Ft. from N. Line


Ft. from S. Line

330

Ft. from E. Line

Ft. from W. Line

NE NE SW

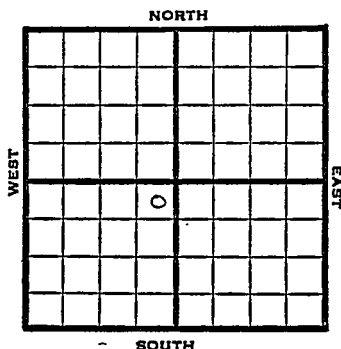

1950 Elev 2877

REPORT

10/18 Spud 10-9-50

10" @ 591

drlg 2455

12/6 10" @ 591

7" @ 2612

Her 2615

TD 2722

15000 A

Comp 12,460,000 gas

Completed

**COMPLETED**


J. E. TYRA

OCT 25 1950

|                      |     |
|----------------------|-----|
| Scout Cards .....    | 7 w |
| Land Small Map ..... | 3   |
| Land Wall Map .....  |     |
| Tracings .....       |     |
| France Map .....     |     |
| Pierce Map .....     |     |
| Misc. ....           |     |

Drig. Data

County Seward State Kansas  
 Sec. 7 (Blk.) 34 (Sur.) 3 3W Map No.  
 Operator Gabot Carbon  
 Well No. 1 Farm Metcalf  
 Elev. 2877 Location NE NE SW

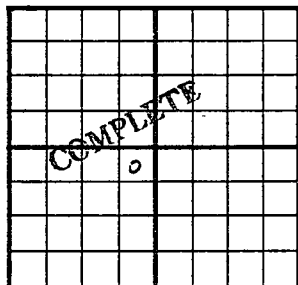

330 Ft. From N Line SW  
330 Ft. From E Line Quarter  
 Ist. Report  
 Completion DEC 6 1950  
 Remarks Hugoton Pool  
 Spudding Date 10-9-50

Drlg. Data Gas well TD 2722  
10" C 591 7" C 2612 Her. 2615  
TD 2722 15000 A Comp. 12,460,000 gas

J. E. TYRA

DEC 12 1950

Scout Cars

Lap 1 11 11 11

Lap 2 11 11 11

Trail 11 11 11

Fr 11 11 11

Picnic 11 11 11

Misc

Drig. Data