

DX 78-1

Barber


KANSAS

Section 8 Township 34 Range 13 W

Well No. # 1 Blunk "B"

Company Imperial Drlg.

NORTH

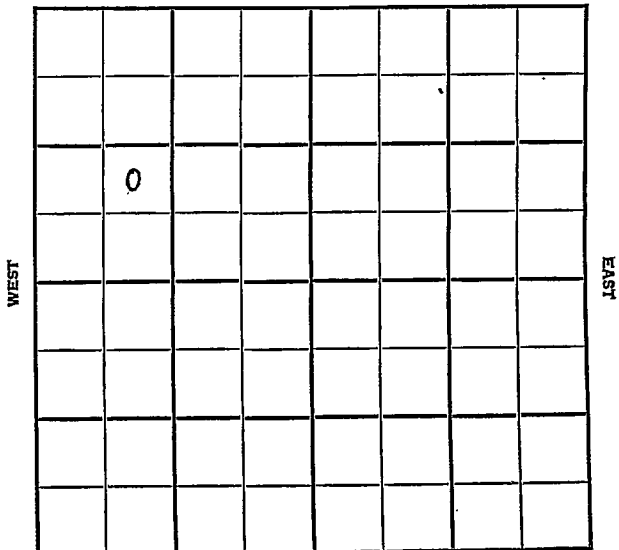

SOUTH

Barber KANSAS

SEC.	TWP.	R.
8	34	13W


WELL NO. 1 Blunk "B" FARM

COMPANY Imperial Drlg.

CONTRACTOR Bill Schafer

S. Medicine Lodge Pool NORTH

_____ Ft. from N. Line
 990 _____ Ft. from S. Line
 _____ Ft. from E. Line
 990 _____ Ft. from W. Line

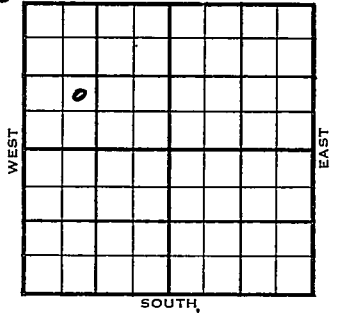

NE SW NW

1954	ELEVATION 1819'	REPORT
------	--------------------	--------

11/23
12/29

Location
 Spud 12-1-54 D & A TD 5360
 8" @ 535
 DST 4202-41 open 1/2 hr rec 270' wtry
 mud, 1384#
 DST 4829-65, open 40 min, rec 20'
 drlg. mud. 42#
 DST 4937-76 open 1 1/2 hr rec 35' mud
 77# Doug. 4172 Bart. 4263
 Lans 4269 Miss 4824 Kh. 5090
 Viola 5197 Simp. 5290 Simp sd 5334
 DST 5336-60 open 1 hr rec 170' gas,
 150' SO & GCM, 540' SW 1879#
 TD 5360' D & A

ABANDONED

County Barber State Kansas
 Sec. 8 (Blk. Twp.) 34 (Sur. Rge.) 13W Map No.
 Operator Imperial Drlg.
 Well No. 1 Farm Blunk "B"
 Elev. 1819 Location NE SW NW

990 Ft. From S Line NW
990 Ft. From W Line Quarter
 Ist. Report
 Completion DFC 29 1954
 Remarks S. Medicine Lodge
Bill Schafer - Contr.
 Spudding Date 12-1-54

ABANDONED

Drlg. Data D & A TD 5360
8" @ 535 DST 4202-41 open 1/2 hr.
Rec. 270' wtry mud 1384# DST 4829-65
open 40 min. Rec. 20' drlg. mud 42#
DST 4937-76 open 1 1/2 hr. Rec. 35' mud
77# Doug. 4172 Bart. 4263 Lans. 4269
Miss. 4824 Kh. 5090 Viola 5197
Simp. 5290 Simp. sd. 5334 DST 5336-60
open 1 hr. Rec. 170' gas 150' so & gcm
540' sw 1879# TD 5360

D & A

FABEN GILSTRAP