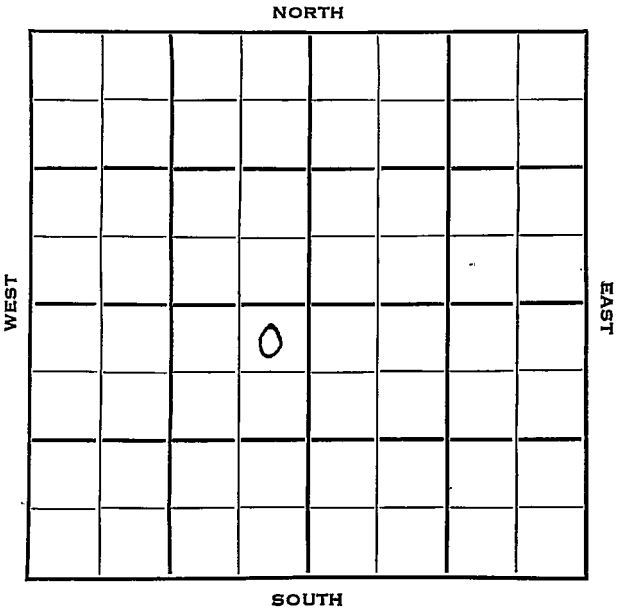


Clark

KANSAS

FORM 51

Section 8 Township 34 Range 24WWell No. #1 GardnerCompany Peters-Writer & Christiansen & I.W.
Siegel

Clark

KANSAS

Sec. 8 Twp. 34 R. 24W 1

Well No. #1 Gardner Farm

Peters-Writer & Christiansen & I Company
W. Siegel


Glenn Nye Contractor
Wildcat.

330 Ft. from N. Line

Ft. from S. Line

330 Ft. from E. Line

Ft. from W. Line

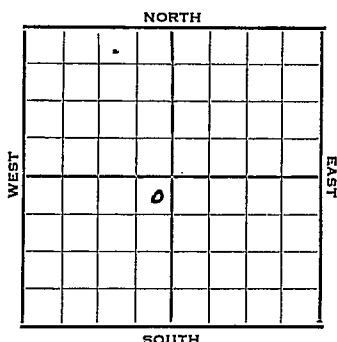

NE NE SW

1953 Elev. 1962' REPORT

7/8 Spud 6-28-53
13" @ 406' w/425 sks
Drlg 3615'

7/22 KC 4416, Oolitic 4714
Drlg.

7/29 TD 5690' 5" @ 5689'

8/5 40/ 5477-88 40/ 5510-20 36/ 5528-37
72/ 5540-58 36/ 5561-70 40/ 5588-98
48/ 5608-20 Packer 5460
1000 A 15 hr. B.D. 1 M 500 A

8/12 5000 A Plug 5502 1000 A 1 M on temp
72-20 est. 4 1/2 M

8/19 Testing.

8/26 "

12/9 "

3/3 "

3/10 Spud 6-28-53
D & A
TD 5690'
13" @ 406'
KC 4416', Oolitic 4714',
DST 5460'-5541' failed.
TD 5690'
5" @ 5689'

OVER

1954

Information brought forward.

3/10 40/ 5477-88 40/ 5510-20 36/ 5528-
37 72/ 5540-58 36/ 5561-70
40/ 5588-98 48/ 5608-20 SP 5460'
1000 A 1 mcfg 1000 A 1 mcfg
4,500,000 gas 1000 A
SP 5524'
5000 A
1 mcfg. Top. 3305',
42/ 5542-46 42/ 5562-68 10,000 A
Lans 4390', Miss 5540'
D & A

ABANDONED

J. G. McGEHEE


JUL 10 1953

Scout Cards	
and other items	
.....	
Francis Map	
Pierce Map	
Misc.	

Drig. Date

4/10/53

County Clark State Kansas
 Sec. 8 (Blk.) 34 (Sur.) 24W Map No.
 Operator Peters, Writer & Christianson &
 Well No. 1 Farm Gardner I.W. Siegel
 Elev. 1962 Location NE NE SW

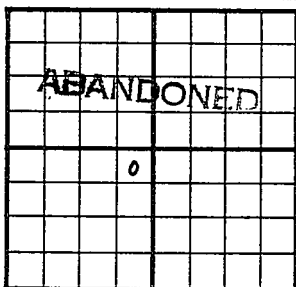

330Ft. From N Line SW
330Ft. From E Line Quarter
 Ist. Report
 Completion MAR 10 1954
 Remarks Wildcat
Glenn Nye - Contr.
 Spudding Date 6-28-53

Drlg. Data D & A TD 5690
13" @ 406 KC 4416 Oolitic 4714
DST 5460-5541 failed TD 5690 5" @ 5689
40/ 5477-88 40/ 5510-20 36/ 5528-37
72/ 5540-58 36/ 5561-70 40/ 5588-98
48/ 5608-20 SP 5460 1000 A 1 mcfg
1000 A 1 mcfg 4,500,000 gas 1000 A
SP 5524 5000 A 1 mcfg Top. 3305
42/ 5542-46 42/ 5562-68 10,000A
Lans. 4390 Miss. 5540

D & A

MAR 15 1934

Scout Cards	
Land Small Map	
Land Wall Map	
Tracings	
France Map	
Pierce Map	
Misc.	

Orig. Date