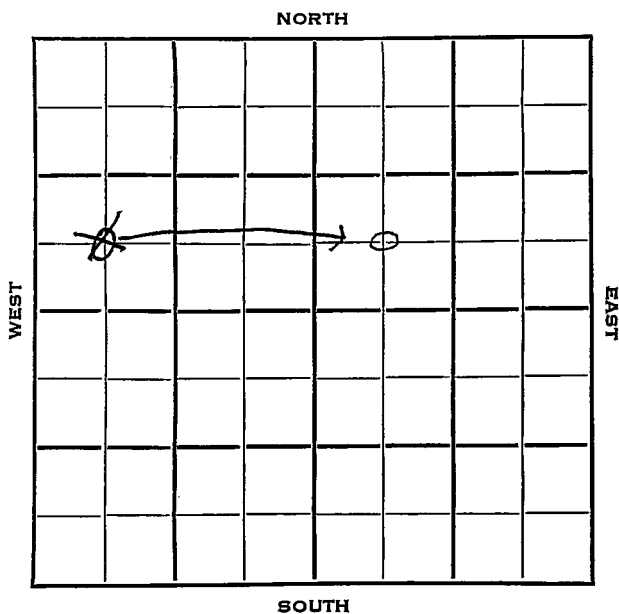


FORM 51

Section 8 Township 34 Range 29WWell No. #1-A AdamsCompany Huber Corp.

Meade

KANSAS

SEC.	TWP.	R.
8	34	29W

WELL NO.

1-A Adams

FARM

COMPANY

Huber Corp.

CONTRACTOR

Ft. from N. Line

660

Ft. from S. Line


Ft. from E. Line

660

Ft. from W. Line

C SW

NE

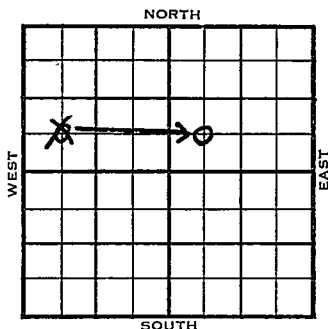

1953

ELEVATION
2570'

REPORT

9/23

Spud 9-20-53
13" @ 640', WOC

9/30

9" @ 2500
Drlg. 2971'

10/7

Drlg 4896'


10/14

Drlg.

10/28

Spud 9-20-53 D & A TD 6110
 13" @ 640 9" @ 2500
 DST 5230-60 open $\frac{1}{2}$ hr rec 980' SW
 DST 5848-89 open $1\frac{1}{2}$ hr rec 340' HO
 & GCM 1175#
 DST 5953-6007 open 1 hr rec 120' mud
 TD 6110' 5" @ 5937 CO to 5897'
 20/5857-62 S/20 GSW 2 GO 500 A
 S/20 GSW 2 GO 12 hr. 20/5832-37
 20/5842-47 S/15 GSW $\frac{1}{2}$ GOPH 16 hr.
 500 A S/40 GSW 4 GOPH
 Her. 2665 Kri. 2711 Win. 2765
 Ft. Riley 2830' Lans 4452'
 Marm. 5323' Morrow 5788'
 Chester 5944' D & A

ABANDONED

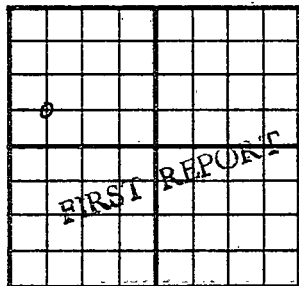County Meade State KansasSec. 8 (Blk. 34 (Sur. 29W (Twp. Map No.Operator Huber Corp.Well No. 1-A Farm AdamsElev. Location C SW NW660 Ft. From S Line NW660 Ft. From N Line Quarter1st. Report SEP 23 1953Completion Remarks Spudding Date 9-20-53Drlg. Data 13" @ 640 WOC

ans29

Map No. _____ Sec. 8 Twp. 34 R. 29WWell No. 1-A Adams

_____ Huber Corp. _____ Company

_____ **CORRECTION** _____ Contractor


C SW NE

SECTION PLAT

_____ Ft. from N. Line

660 Ft. from S. Line

_____ Ft. from E. Line

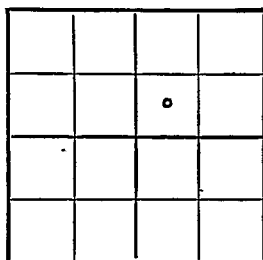660 Ft. from W. Line

Meade County

Location _____

Rig up _____

Drilling and Remarks:

Reported

C SW NW

RECORD

Cased _____ in., _____ ft.

Sand _____

Gas _____

Oil _____

Total Depth _____

PRODUCTION

1st 24 hrs. Nat. _____

1st 24 hrs. after shot _____

Gas _____ Cu. Ft.

Dry Hole _____

Abandoned _____

Date

OCT 7 1959

J. G. McGEHEE


Scout

County Meade State Kansas
 Sec. 8 (Blk.) 34 (Sur.) 29W Map No.

Operator Huber Corp.

Well No. 1-A Farm Adams

Elev. 2570 Location C SW NE

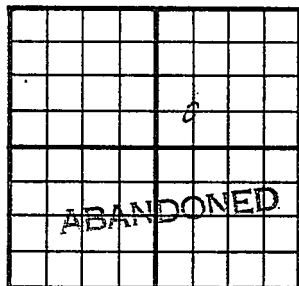

660 Ft. From S Line NE

660 Ft. From W Line Quarter

1st. Report

Completion OCI 28 1953

Remarks

Spudding Date 9-20-53

Drlg. Data D & A TD 6110

13" @ 640 9" @ 2500 DST 5230-60

open $\frac{1}{2}$ hr. Rec. 980' sw DST 5848-89

open $1\frac{1}{2}$ hr. Rec. 340' ho & gcm 1175#

DST 5953-6007 open 1 hr. Rec. 120' mud

TD 6110 5" @ 5937 CO to 5897

20/ 5857-62 S/ 20 gsw 2 go 500 A

S/ 20 gsw 2 go 12 hr. 20/ 5832-37

20/ 5842-47 S/ 15 gsw $\frac{1}{2}$ goph 16 hr.

500 A S/ 40 gsw 4 goph

Her. 2665 Kri. 2711 Win. 2765

Ft. Riley 2830 Lans. 4452 Marm. 5323

Morrow 5788 Chester 5944

D & A

J. G. McGEHEE