


Section 8 Township 34 Range 33-WWell No. #1 FitzgeraldCompany C S O

NORTH

WEST

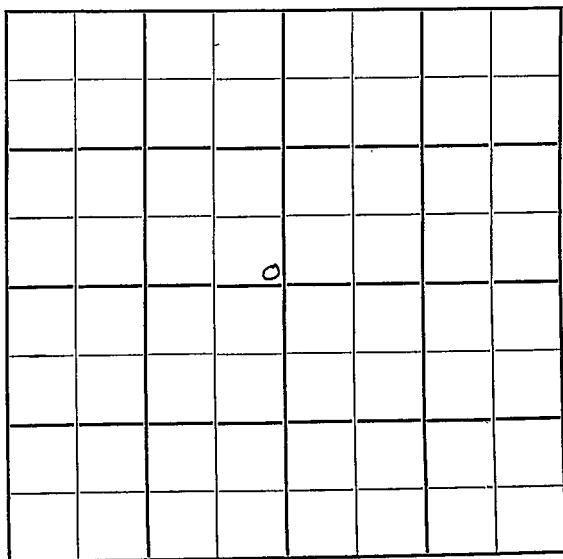

EAST

SOUTH

Seward

KANSAS

Sec. 8 Twp. 34 R. 33W

Well No. #1 Fitzgerald Farm

C SO Company

Contractor

Hugoton Pool


Ft. from N. Line

100' Ft. from S. Line

100' Ft. from E. Line

Ft. from W. Line

SE NW

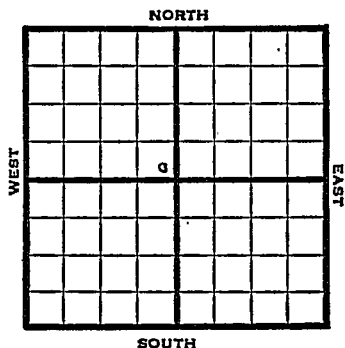

1950

Elev 2887

REPORT

6/21

Location

8/16

8" @ 640

5 1/2" @ 2899

TD 2800

10/2790-92, 100/2754-74, 150/2696-2726

40/2668-76, 40/2642-50

Per 2642

Krider 2667

Win 2753

17000 total acid

Comp 8,000,000 gas

Completed

COMPLETED

~~Kansas~~

Hugoton Pool


Map No. _____ Sec. 8 Twp. 34 R. 33WWell No. 1 FitzgeraldC S O

Company

Contractor

SE NW

SECTION PLAT

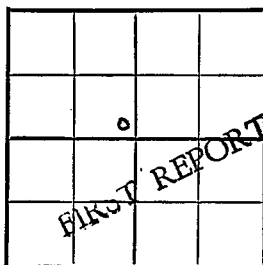

_____ Ft. from N. Line

100 Ft. from S. Line100 Ft. from E. Line

_____ Ft. from W. Line

Seward County

Location X

Rig up _____

Drilling and Remarks:

RECORD

Cased _____ in., _____ ft.

Sand _____

Gas _____

Oil _____

Total Depth _____

PRODUCTION

1st 24 hrs. Nat. _____

1st 24 hrs. after shot _____

Gas _____ Cu. Ft.

Dry Hole _____

Abandoned _____

Date

JUN 21 1950 19J. E. TYRA Scout


Scout Council of America





 




Scout Cards

Land Small Map

Land Wall Map

Tracings

France Map

Pierce Map

Misc.

JUN 23 1950

J. E. TYRA

Scout Cards

Land Small Map

Land Wall Map

Tracings

France Map

Pierce Map

Misc.

AUG 21 1950

Drig. Data