


Marion

KANSAS

SECTION 8 TOWNSHIP 34 RANGE 43W

WELL NO. #1 Gov't "B"

COMPANY Huber

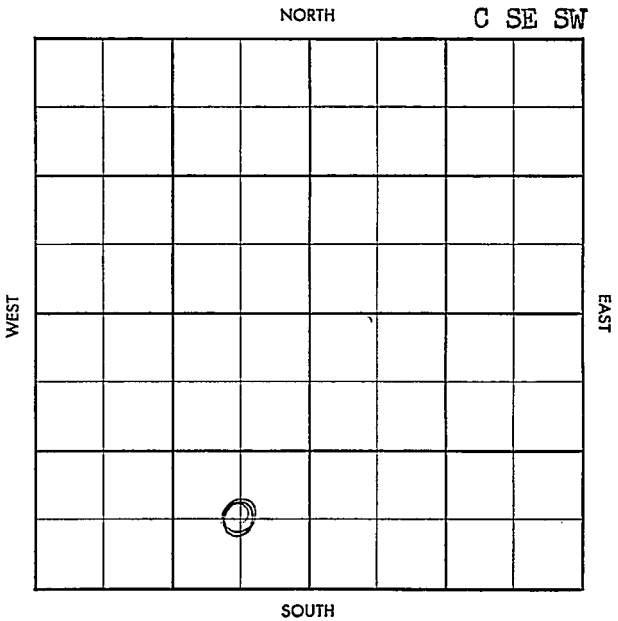

County Monroe Elev. _____
 Sec. 8 Twp. 34 Rge. 13W
 Company Huber
 Farm Name Gov't "B" No. 1

Co.

Lse.

No.

Sec.

T.

R.

TOPS	DEPTH	LOG	DATUM
Anh.			
Ip.			
H.			
Tr.			
Dg.			
Bl.			
L.			
K.C.			
B.K.C.			
Ce.			
C.			
M.			
M.			
K.			
Mz.			
Me.			
V.			
S.			
S.			
A.			
R.			
Pe.			
G.			
TD.			

Loc. in Sec. _____

C SE SW

Geol. _____

Contr. _____

Co. tools _____

Pool _____

Interstate _____

FIRST REPORT

SEP 12 57

0

Date Comm. 9-12-57
8" @ 1251 drlg. 3336

K-20

FORM 513 SUNRAY

County Morton Elev. 3606 D.E.
Sec. 8 Twp. 34 Rge. 43W
Company Huber
FarmName Gov't "B" No. 1

TOPS	DEPTH	LOG	DATUM	Loc. in Sec.
Anh				
Ip		2908		C SE SW
H. <u>Elm</u>		2812		
Tr. <u>La Com</u>		3052		
Dg. <u>Men 56</u>		4228		
Bl. <u>Purdy</u>		4316-68		
L.				
K.C.				Geol.
B.K.C.				Contr.
Ce.				
C.				Co. tools
M.				
M.				Pool
K.				Interstate
Mz.				
Ma.				
V.				
S.				
S.				
A.				
R.				
PE.				
G.				
T.D.	4386	4386		

COMPLETE

OCT 16 57

Date Comm. 9-12-57
8" @ 1251 drlg. 3336
5 1/2 4384/150 WOC
8/4334-36 FU 2000 SW
SS O & G 30" SQD 8/4322
-24 15 g Fit SS O & G
40/4312-22 \$ 87 BO NW
9 hrs \$ 8.35 BO NW
1 hr POP OCT 9 57 OCT 16 57
PHY P 112 BO me 24 hrs
4312-22