

Barber


KANSAS

SECTION 9 TOWNSHIP 34 RANGE 11W

WELL NO. #1 Page

COMPANY Perkins Bros.

NORTH

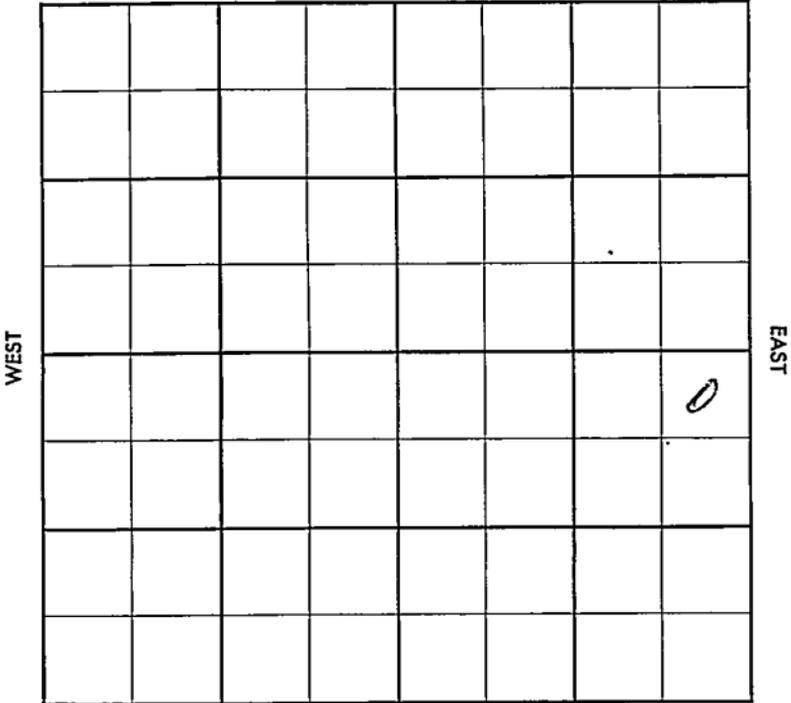

SOUTH



County Barber Elev. \_\_\_\_\_  
 Sec. 9 Twp. 34 Rge. 11W  
 Company Perkins Bros.  
 Farm Name \_\_\_\_\_ Page \_\_\_\_\_ No. 1

TOPS	DEPTH	LOG	DATUM
Anh.			
Tp.			
H.			
Tr.			
Dg.			
Bl.			
L.			
K.C.			
B.K.C.			
Ce.			
C.			
M.			
M.			
K.			
Mz.			
Ma.			
V.			
S.			
S.			
A.			
R.			
Pe.			
G.			
TR.			

Loc. in Sec. NE NE SE  
 Geol. \_\_\_\_\_  
 Contr. \_\_\_\_\_  
 Pool \_\_\_\_\_

FIRST REPORT  
 MAY 9 '55

Date Comm. \_\_\_\_\_  
 Location \_\_\_\_\_

REC. I YAM

R.G.

Co.  
Lse.  
No.  
Sec.  
T.  
R.

County Barber Elev. 1611 DF  
 Sec. 9 Twp. 34 Rge. 11W  
 Company Perkins Bros.  
 Farm Name Page No. 1


TOPS	DEPTH	LOG	DATUM
Anb.			
Tp. <u>shaw</u>	<u>2338</u>		
H.			
Tr.	<u>3880?</u>		
Dg. <u>sd</u>	<u>3940</u>		
Bl.			
L.	<u>4078</u>		
K.C.			
B.K.C.			
Ce.			
C.			
M.	<u>46968</u>		
M.			
K.			
Mz.			
Mq.			
V.			
S.			
S.			
A.			
R.			
PE.			
G.			
TD.	<u>4927</u>		

Loc. in Sec. NE NE SE

Geol. \_\_\_\_\_

Contr. \_\_\_\_\_

Pool \_\_\_\_\_

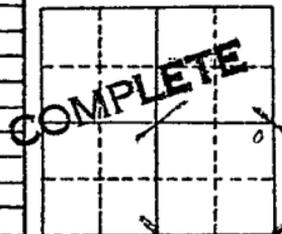

Date Comm. \_\_\_\_\_

JUN 27 '56

Location MAY 16 '56 5-1-56 10" @

355/325 # 4332 MAY 23 '56

DST 4683-4927 45" g to s, 19" est 10 MCF rec 261' GCM BHP

Failed Rn9 csq. MAY 29 '56 5 1/2 @

@ 4927 42/4693-4700

A # 26 BWT568 hrs JUN 6 '56

5" 4752/2755 ft, # fine ga 3.50, net

75 RW 50 JUN 13 '56 SETP 100" Ga 5.5 WVEG

Co.

Lse.

No.

Sec.

T.

R.

9-24-1451

NE NE SE

JUN 21

JUN 27 '58

cal or F/W: 770

MCFG pd.

245