


DX 78-1

Barber KANSAS

Section 9 Township 34 Range 15 W

Well No. # 1 Davis Ranch "B"

Company Chicago Corp.

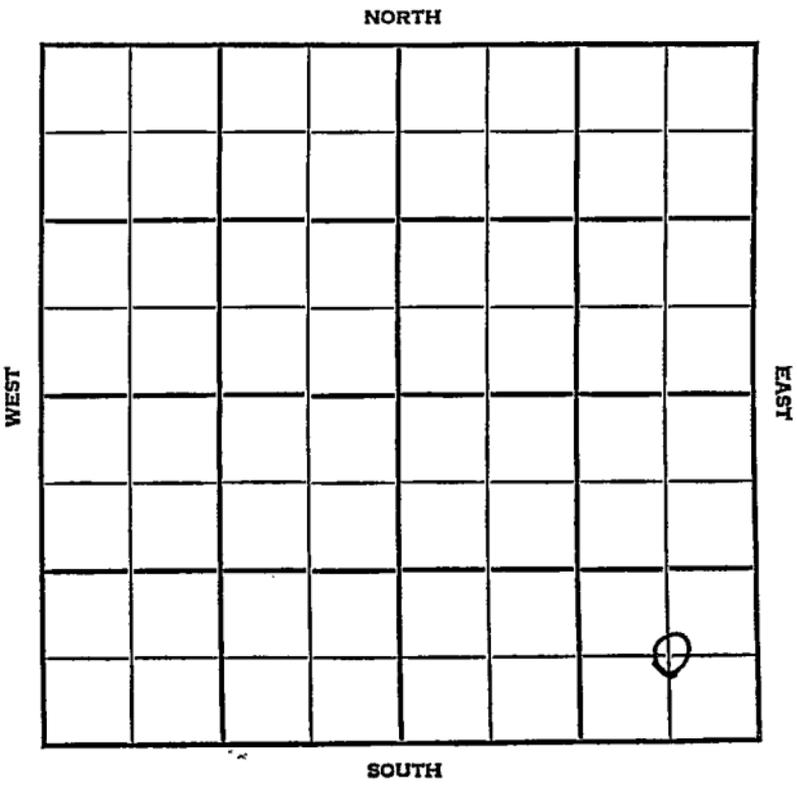

Barber

KANSAS

SEC.	TWP.	R.
9	34	15W

WELL NO.

#1 Davis Ranch "B"

FARM

COMPANY

Chicago Corp.

CONTRACTOR

Big Chief


Wildcat.

\_\_\_\_\_ Ft. from N. Line

660 \_\_\_\_\_ Ft. from S. Line

660 \_\_\_\_\_ Ft. from E. Line

\_\_\_\_\_ Ft. from W. Line

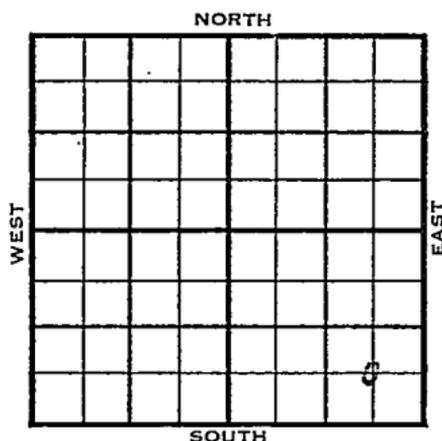

C SE SE

	ELEVATION	REPORT
1955	1597'	
2/23	Location	
4/20	Spud 3-14-55 D & A TD 5378 9-5/8" @ 424 Elgin 3703 Heeb 3892 Doug 3921 KC 4105 DST 4330-50 open 1 hr rec 910' VSO & GCSW 1620# DST 4434-80 open 1 hr rec 65' drlg. mud. 683# DST 4482-4521, open 2 hr rec 720' gas, 90' HO & GCM, 90' MO & GCSW 860# DST 4529-50 open 2 hr rec 120' SGCM 315# B KC 4595' Marm 4607' Miss 4746 Kh. 4989' Kh lime 5029', Chattanooga 5058', Viola 5088 DST 5075-5100, open 2 hr, rec 30' VSGC & oil spot mud. 45# DST 5094-5134 open 2 hr, rec 10' drlg mud 90# Simp sh 5218' Simp sd 5228 EST 5209-46 open 2 hr rec 1270' SW 1960# Arb. 5348' DST 5349-60 open 1 hr rec 10' drlg. mud. 1370# DST 5353-78 open 2 hr rec 2130' SW 2070# TD 5378' D & A	

ABANDONED





County Barber State Kansas  
 Sec. 9 (Blk. 34 (Sur. 15W Map No. )  
 Operator Chicago Corp.  
 Well No. 1 Farm Davis Ranch "B"  
 Elev. 1597 Location C SE SE


660 Ft. From S Line SE  
660 Ft. From E Line Quarter  
 Ist. Report   
 Completion APR 20 1955  
 Remarks Wildcat  
Big Chief - Contr.  
 Spudding Date 3-14-55

Drlg. Data D & A TD 5378  
9 5/8" @ 424 Elgin 3703 Heeb. 3892  
Doug. 3921 KC 4105 DST 4330-50  
open 1 hr. Rec. 910' vso & gcsw 1620#  
DST 4434-80 open 1 hr. Rec. 65' drlg.  
mud 683# DST 4482-4521 open 2 hr.  
Rec. 720' gas 90' ho & gcm 90' mo & gcsw  
860# DST 4529-50 open 2 hr. Rec. 120'  
sgcm 315# B KC 4595 Marm. 4607  
Miss. 4746 Kh. 4989 Kh lime 5029  
Chattanooga 5058 Viola 5088  
DST-5075-5100 open-2 hr. Rec. 30' vsge &  
oil spot mud -45# DST 5094-5134 open  
2 hr. Rec. 10' drlg. mud 90#  
Simp. sh. 5218 Simp. sd. 5228 DST 5209-

FABEN GILSTRAP

APR 26 1955

Scout Cards	mm
Land Sheet Map	
Trails	52
France Map	
Pierce Map	
Misc.	
D & A	

TD 5378

open 2 hr. Rec. 2130' sw 2070#

Rec. 10' drlg. mud 1370# DST 5353-78

Arb. 5348 DST 5349-60 open 1 hr.

46 open 2 hr. Rec. 1270' sw 1960#

Drig. Data