

KANSAS


Seward

FORM 51 25M 3-49 PETROL

Section 9 Township 34 Range 33-W

Well No. #1 Breifert

Company Cities Service

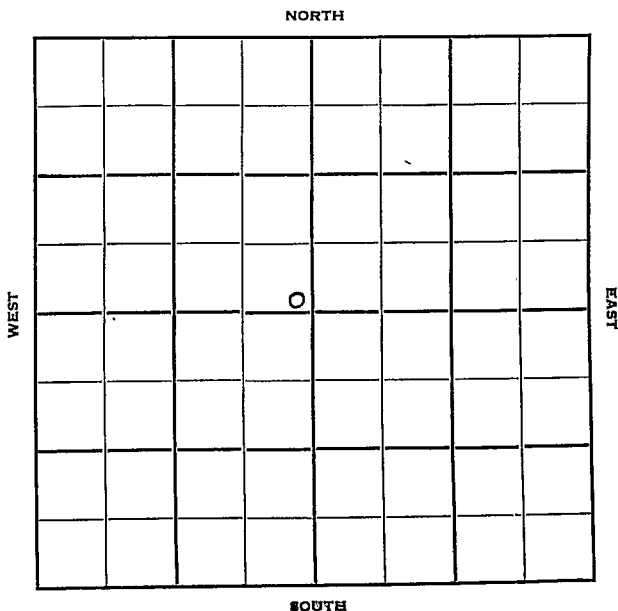

Seward KANSAS

Sec. 9 Twp. 34 R. 33W

Well No. #1 Breifert Farm

Cities Service Company

Contractor

Hugoton Pool


Ft. from N. Line

100' Ft. from S. Line

100' Ft. from E. Line

Ft. from W. Line

SE SE NW

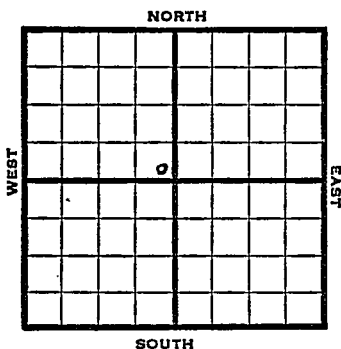

1950

Elev 2876

REPORT

7/5

Spud 6-30-50
8" @ 680'

8/30

8" @ 680

5" @ 2799

TD 2800

Her 2642

Krider 2670

Win 2759

120/2704-28, 70/2698-2712

60/2666-78, 60/2642-54, 13000 total acid

Comp 8,260,000 gas

Completed

COMPLETED

Kansas

Map No. _____ Sec. 9 Twp. 34 R. 33WWell No. 1 Breifert

_____ Cities Service _____ Company

_____ Contractor


SE SE NW

_____ Ft. from N. Line

100 Ft. from S. Line100 Ft. from E. Line

_____ Ft. from W. Line

SECTION PLAT

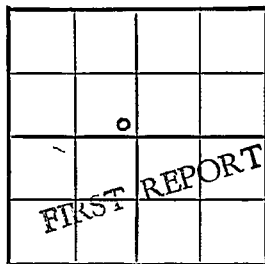

Seward County

Location _____

Rig up _____

Drilling and Remarks: _____

Spud 6 -30'-50'

8" C 680

RECORD

Cased _____ in., _____ ft.

Sand _____

Gas _____

Oil _____

Total Depth _____

PRODUCTION

1st 24 hrs. Nat. _____

1st 24 hrs. after shot _____


Gas _____ Cu. Ft.

Dry Hole _____

Abandoned _____

Date

JUL 5 1950 19J. E. TYRA Scout

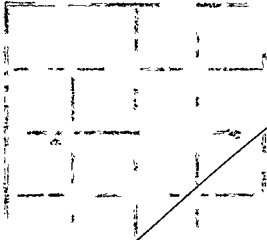


Scout Cards
Land Small Map
Land Wall Map
Tracings
France Map
Pierce Map
Misc.

Scout Cards
Land Small Map
Land Wall Map
Tracings
France Map
Pierce Map
Misc.

1958

County Seward State Kansas
 Sec. 9 (Blk. 34 (Sur. 3 3W Map No. 34)
 Operator Cities Service
 Well No. 1 Farm Breifert
 Elev. 2876 Location SE SE NW

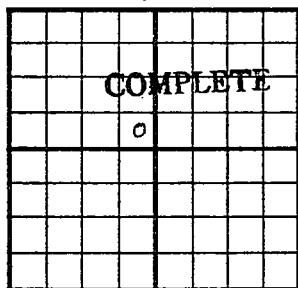

100 Ft. From S Line NW
100 Ft. From E Line Quarter

1st. Report

Completion AUG 30 1950

Remarks

Hugoton Pool

Spudding Date 6-30-50

Drlg. Data Gas well TD 2800

8" @ 680 5" @ 2799 TD 2800

Jer. 2642 Krider 2670 Win. 2759

120/ 2704-28 70/ 2698-2712 60/ 2666-78

60/ 2642-54 13000 total acid

Comp. 8,260,000 gas

J. E. TYRA

Scout Cards	70
Land Small Map	3
Land Wall Map	
Tracings	
France Map	
Pierce Map	
Misc	

SEP 5

1950

Orig. Data