


Section 9 Township 34 Range 40 W

Well No. # 1 Candall #Rt

Company Cities Service

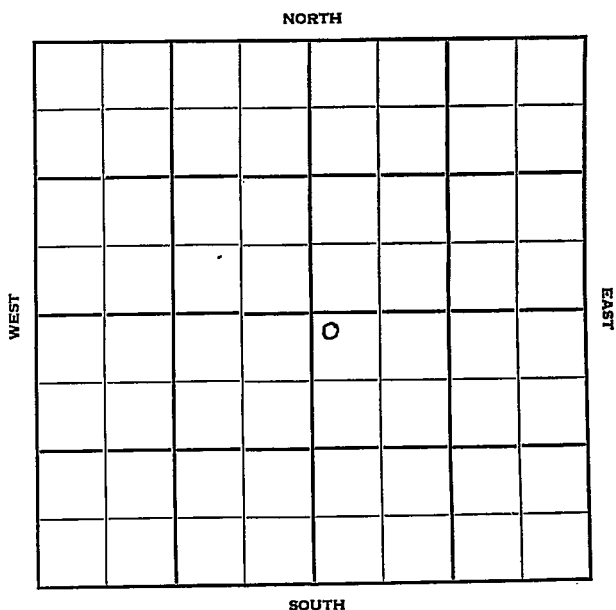

Morton

KANSAS

Sec. 9 Twp. 34 R. 40 W

Well No. # 1 Candall "B" Farm

Cities Service Company

Holm Drlg. Contractor

Hugoton Pool


225 Ft. from N. Line

 Ft. from S. Line

 Ft. from E. Line

225 Ft. from W. Line

NW SE

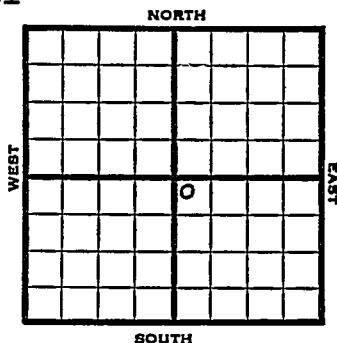

1951

Elev. 3353' REPORT

3/28

Location

5/9

Spud 3-29-51

Gas Well TD 2645

8-5/8" @ 360

Krider 2450 Win. 2520

Ft. Riley 2591

40/2592-2600 60/2546-58

130/2514-40 100/2474-94

80/2450-66 18,500 A


5" @ 2644 Comp. 10,200,000 gas

405#

COMPLETED

J. E. TYRA

County Morton State Kansas
 Sec. 9 (Blk. 34 (Sur. 40W Map No.)
 Operator Cities Service
 Well No. 1 Farm Candall "B"
 Elev. 3353 Location NW SE

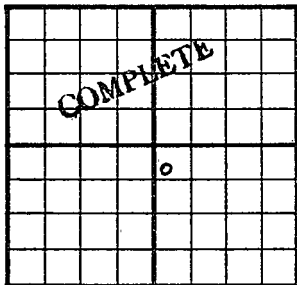

225 Ft. From N Line SE
225 Ft. From W Line Quarter

1st. Report
Completion MAY 9 1951
Remarks Hugoton Pool
Holm Drlg. - Contr.
Spudding Date 3-29-51

Drlg. Data Gas well TD 2645
8 5/8" @ 360 Krider 2450 Win. 2520
Ft. Riley 2591 40/ 2592-2600
60/ 2546-58 130/ 2514-40 100/ 2474-94
80/ 2450-66 18500 A 5" @ 2644
Comp. 10,200,000 gas 405#