


Morton

KANSAS

SECTION 1 TOWNSHIP 35 RANGE 42W

WELL NO. #1 Archil E. Cyr

COMPANY Carter Oil

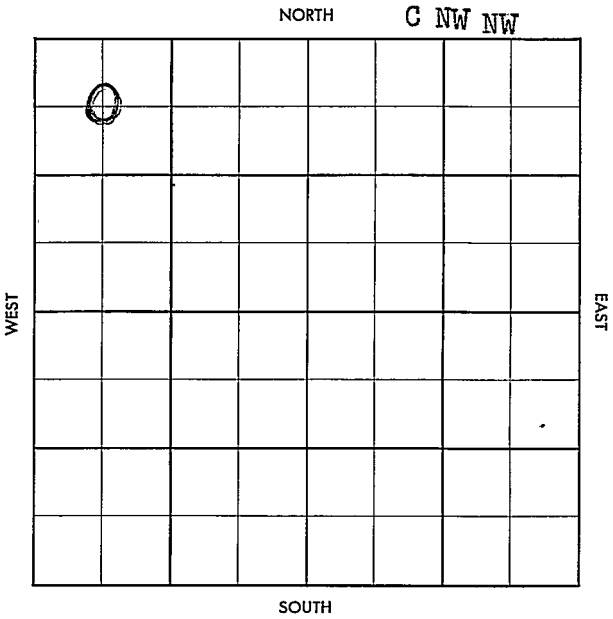

TOPS	DEPTH	LOG	DATUM	Loc. in Sec.
Anh.				C NW NW
Tr.				Morrow test.
H.				
Tr.				
Dg.				
BL.				
L.				Geol.
K.C.				
B.K.C.				Contr.
Ce.				
C.				
M.				
M.				Pool
K.				Taloga
Mz.				
Me.				
V.				
S.				
S.				
A				
R.				
Pe.				
G.				
T.D.				

Lse.

No.

0	JUL 3 '57
FIRST REPORT	

Location

County Morton Elev. 3531
 Sec. 1 Twp. 35 Rge. 42W
 Company Carter Oil
 Farm Name Archil E. Cyr No. 1

TOPS	DEPTH	LOG	DATUM	Loc. in Sec.
Anh.	<u>1444</u>			C NW NW
TP.				
H.				Morrow test
Tr.				
Dg. <u>W26</u>	<u>2769</u>	<u>2814</u>		
Bl. <u>TP</u>		<u>3035</u>		
L. <u>-650</u>	<u>3225</u>	<u>3289</u>		Geol.
K.C. <u>LS9</u>	<u>3444</u>	<u>3499</u>		
B.K.C. <u>CB</u>		<u>4238</u>		Contr.
Ce. <u>MLW 5h</u>	<u>4530</u>	<u>4532</u>		
C. <u>" 3d</u>		<u>4598-4621</u>		
M. <u>"C" 3d</u>	<u>4597</u>			
M.				Pool
K.				Taloga
Mz.				
Mq.				
V.				
S.				
S.				
A.				
R.				
PE.				
G.				
T.D.	<u>4620</u>			

COMPLETE

JUL 31 '57

Date Comm.

Location JUL 10 '57 7-3-57 85/8
1456-1050 1 JUL 17 '57 @ 3967
JUL 24 '57 Cored 4600-15 rec 15' FT
" 4615-29 rec 13 1/2 FT
5 1/2 4669 / 300 WOCT JUL 31 '57 Co 4631
72 / 4599-4611 @ 8' Flwd 84 Bo no/w
8 hrs gran 39.2° calc. 252
Bopd no/wtr.