


Form 51-5M-1-30-38840

Map No. _____ Sec. 1 Twp. 35 R. 38

Well No. 1-Beavers Farm

Rosenthal - Pioneer Company

NORTH

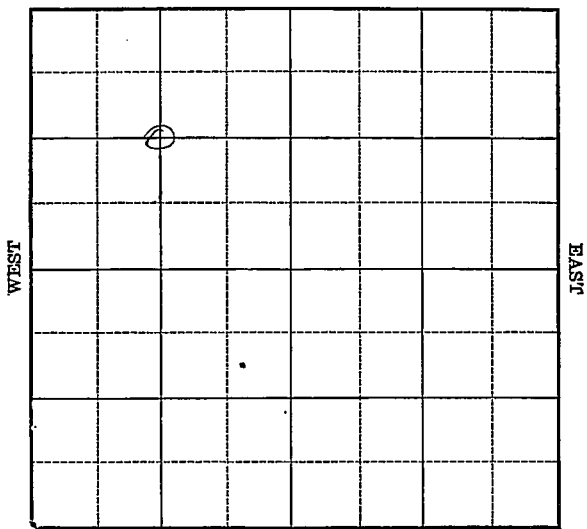

SOUTH

Location_____

Drilling Remarks

Rig Up _____
Drilling Remarks

RECORD

Cased _____ in. _____ ft.

Sand _____

Gas _____


Oil _____

Total Depth _____

PRODUCTION
1st 24 hrs. Nat. _____
1st 24 hrs. after shot _____
Gas _____ cu. ft. _____
Dry Hole _____
Abandoned _____

Map No. KANSAS Sec. 1 Twp. 35 R. 38^w
 Well No. 1-Beavers Farm
Rosenthal & Cronus Company

NORTH

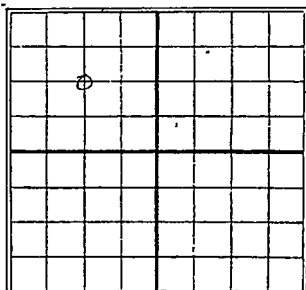

1320 Ft. from N. Line

_____ Ft. from S. Line

_____ Ft. from E. Line

1320 Ft. from W. Line

1930

SOUTH

Date / REPORT

8/20 Bldg rotary rig

8/27 _____

9/3 Hdg. 627'

9/10 " 1185'

9/17 " 2515'

9/24 8"-2555 Rust

10/1 No report

10/8 Sand 2631-2834

T.D. 2834

8 3/4 M. Gas
 Comp.

Stevens

Map No. **KANSAS** Sec. 1 Twp. 35 R. 38^WWell No. 1 BeaversRosenthal & Pioneer Company

Contractor

FIRST REPORTS

1320 Ft. from N. Line

_____ Ft. from S. Line

_____ Ft. from E. Line

1320 Ft. from W. Line

SECTION PLAT

Location _____

Rig up _____

Drilling and Remarks:

Big Rat Rig.

RECORD

Cased _____ in., _____ ft.

Sand _____

Gas _____

Oil _____

Total Depth _____

PRODUCTION

1st 24 hrs. Nat. _____

1st 24 hrs. after shot _____

Gas _____ Cu. Ft.

Dry Hole _____

Abandoned _____

Date

AUG 20 1930

CHAS. L. SHERWOOD

19

Scout

no wall
no small map

Returned	
Cards	
Tracing	X
France Map	X
Scarborough Map	X
Moody Map	X
Scarborough Plat Book	
Moody Plat Book	

Map No. KANSAS Sec. 1 Twp. 35 R. 38 W

Well No. 1 Beaver

Rosenthal & Poirer Company

Contractor

SECTION PLAT


1320 Ft. from N. Line

..... Ft. from S. Line

..... Ft. from E. Line

1320 Ft. from W. Line

COMPLETED

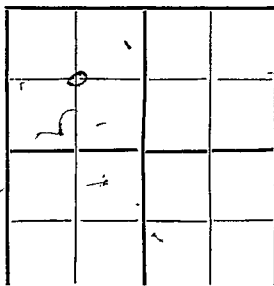

Location.....

Rig up.....

Drilling and Remarks:

RECORD

Cased..... in., ft.

Sand 2631-2834

Gas 8 3/4 MI

Oil.....

Total Depth 2834

PRODUCTION

1st 24 hrs. Nat.....

1st 24 hrs. after shot.....

Gas..... Cu. Ft.

Dry Hole.....

Abandoned.....

Date

OCT 8 1930

S. J. LEWIS Scout

no more
no more

Returned	
Cards	
Tracing	X
France Map	X
Scarborough Map	X
Moody Map	X
Scarborough Plat Book	
Moody Plat Book	