Stevens

FORM 51 IOM 12-46 PETROL


KANSAS

Section 1 Township 35 Range 36W

Well No. #1 Hagaman

Company Northern Natural Gas

Hugoton

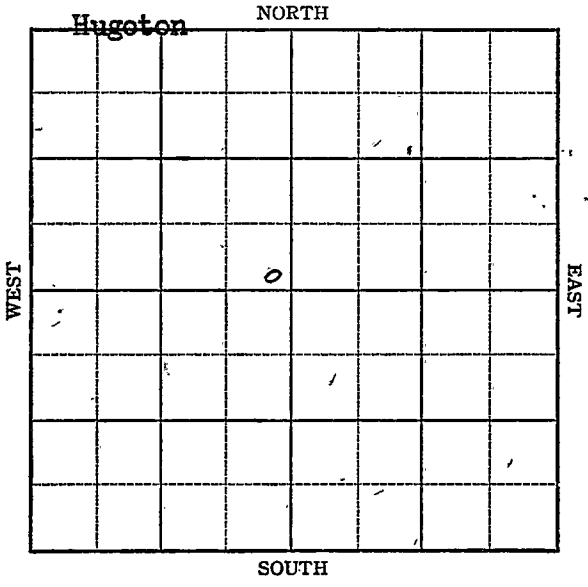

FORM 252-A
5M 12-46 PETROL

KANSAS


Stevens

Sec. 1 Twp. 35 R. 36-W

Well No. #1 Hagaman Farm

Northern Natural Gas Company

Hugoton Pool

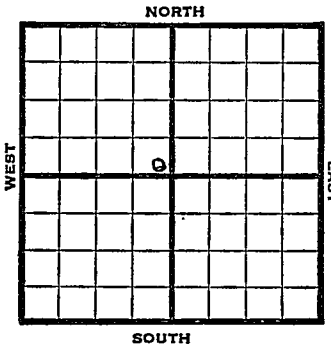

____ Ft. from N. Line

100 Ft. from S. Line

100 Ft. from E. Line

____ Ft. from W. Line

SE NW -

1947	Elev. 3028' REPORT
4/30	Location
5/7	"
5/13	RUR
5/20	"
5/27	10" @ 688' Drlg. 2100'
6/3	TD 2620' 7" @ 2573 RUST
6/10	Drlg. 2635'
6/17	TD 2818' 255' of 5" perf. liner @ 2818' 16000 Acid.
6/25	TD 2818' 7" @ 2573 255' of 6" Perf liner @ 2878 16000 Acid 25,825,000 Gas 411# R. Pr. Complete

COMPLETED

Form 26 200 Bks. 10-46 Petrol Kansas

Hugoton Pool

Map No. ____ Sec. 1 Twp. 35 R. 36W

Well No. 1 Hagaman


Northern Natural Gas Company

FIRST REPORT

Contractor

SE NW

SECTION PLAT

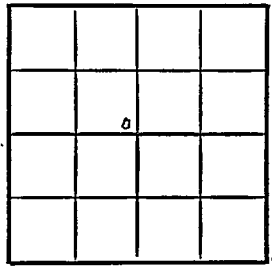

____ Ft. from N. Line

100 Ft. from S. Line

100 Ft. from E. Line

____ Ft. from W. Line

Stevens County

Location X

Rig up

Drilling and Remarks:

RECORD

Cased ____ in., ____ ft.

Sand

Gas

Oil

Total Depth

PRODUCTION

1st 24 hrs. Nat.

1st 24 hrs. after shot

Gas ____ Cu. Ft.

Dry Hole

Abandoned

Date

APR 30 1947 19

S. J. LEWIS Scout

Form 26 200 Bks. 10-46 Petrol

Kansas

Hugoton Pool

Map No. ○ Sec. 1 Twp. 35 R. 36W

Well No. 1 Hagaman


Northern Natural Gas Company

COMPLETE Contractor

SE NW

E 1,3025'

SECTION PLAT

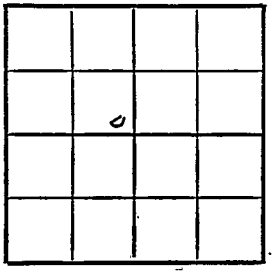

Ft. from N. Line

100 Ft. from S. Line

100 Ft. from E. Line

Ft. from W. Line

Stevens County

Location

Rig up

Drilling and Remarks:

7" @ 2528

255' of 6" Perf liner @ 2878.

16000 acres

25,825,000 Gas

#11 # R.P.

RECORD

Cased in., ft.

Sand

Gas

Oil

Total Depth 2878

PRODUCTION

1st 24 hrs. Nat.

1st 24 hrs. after shot

Gas Cu. Ft.

Dry Hole

Abandoned

Date

JUN 25 1947 19

S. J. LEWIS Scout