

Barber


KANSAS

SECTION 1 TOWNSHIP 35 RANGE 13W

WELL NO. #1 Barta-Platt Comm.

COMPANY Aurora Gasoline

NORTH C NE NE

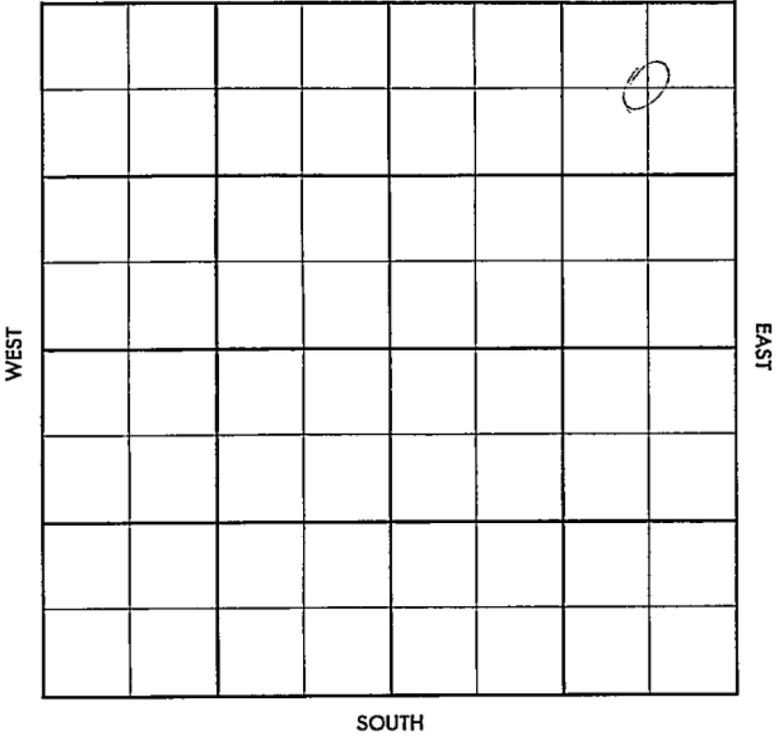

County Barber

Elev. _____

Sec. 1

Twp. 35

Rge. 13W

Company Aurora Gasoline

Farm Name Bartz-Platt Comm

No. 1

| TOPS | DEPTH | LOG | DATUM |
|--------|-------|-----|-------|
| Anh. | | | |
| Ip. | | | |
| H. | | | |
| Tr. | | | |
| Dg. | | | |
| Bl. | | | |
| L. | | | |
| K.C. | | | |
| B.K.C. | | | |
| Ce. | | | |
| C. | | | |
| M. | | | |
| M. | | | |
| K. | | | |
| Mz. | | | |
| Mq. | | | |
| V. | | | |
| S. | | | |
| S. | | | |
| A. | | | |
| R. | | | |
| Pe. | | | |
| G. | | | |
| T.D. | | | |

Loc. in Sec. _____

C NE NE

Geol. _____

Contr. _____

Barbour Tool

Pool _____

Hardtner

| | |
|--------------|---|
| MAR 13 57 | 0 |
| FIRST REPORT | |

Date Comm. 3-10-57

8" @ 261/225, Drlg. 650

~~26~~

Co.

158

No.

Sec.

T.

R.

County Barber Elev. 1436

Sec. I Twp. 35 Rge. 13W

Company Aurora Gasoline

FarmName Bartz-Platt Comm No. 1

| TOPS | DEPTH | LOG | DATUM | Loc. in Sec. |
|---------------------|-------------|-------------|-------|-------------------|
| Anh. <u>E19</u> | | <u>2622</u> | | <u>C NE NE</u> |
| TP. | | | | |
| H. | | <u>3835</u> | | |
| Tr. | | <u>3844</u> | | |
| Dg. | | <u>3909</u> | | |
| Bl. | | <u>4096</u> | | |
| L. | | <u>4112</u> | | |
| K.C. | | | | Geol. |
| B.K.C. <u>ce sh</u> | | <u>4708</u> | | Contr. |
| Ce. <u>sd pay</u> | <u>4755</u> | | | <u>Barbour To</u> |
| C. <u>ce sd</u> | | <u>4756</u> | | |
| M. <u>shly</u> | | <u>4772</u> | | Pool |
| M. <u>chatt</u> | | <u>4795</u> | | <u>Hardtner</u> |
| K. <u>Base Miss</u> | | <u>4824</u> | | |
| Mz. | | | | |
| Mo. | | | | |
| V. | | | | |
| S. | | | | |
| S. | | | | |
| A. | | | | |
| R. | | | | |
| PE. | | | | |
| G. | | | | |
| T.D. | <u>4840</u> | | | COMPLETE |

Date Comm. 3-10-57

8" @ 261/225, Drlg. 650 W. 2057 ID 3875
 DST 4743-67 2 hrs G/7 1/2"
 ga 130 MCF/30" end 2 hrs
 ga 320 MCF see 70' GCM
 BHP 1360/30" ID 4760 with 3 T.D.
 DST 4776-90 op 1 hr G/15"
 TSTM see 65' GCM (550) FP 15
 -15 BHP 1822 DST 4796-4840
 1 hr G/8" see 660' MCO BHP 1530

5 1/2 4840/200 APR 10 '57 APR 11 '57 APR 23 '57
 MAY 1 '57 WOCT JAN 8 '57 MICT MAY 15 '57
 32/4796-4804 § 3 BO C'M
 2 hrs S.D. for Mud. MAY 22 '57 FLOW
 1/2 Flow 165 BO no/w
 6 hrs Thru csg. MAY 29 '57 JUN 5 '57
 Flow 55 BO no/w 45" 1/2"
 ch JUN 12 '57 FLOW 37 BO pd
 no/w