


Map No. **KANSAS** Sec. 10 Twp. 35 R. 39^w
 Well No. 1-Bledin Farm
Pinney - Coastal Company

NORTH

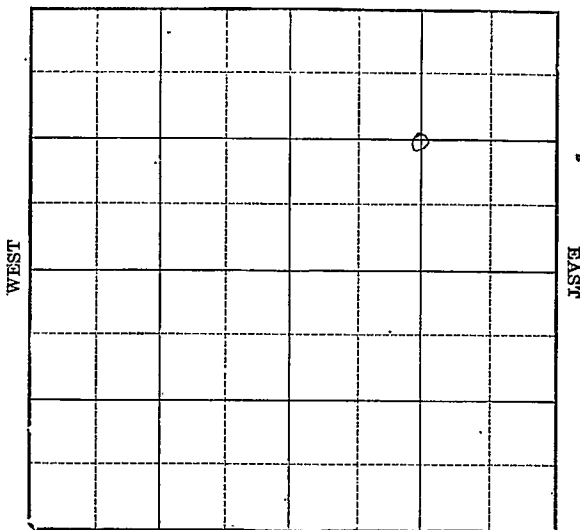

SOUTH

Location _____
 Drilling Remarks _____

Rig Up _____
 Drilling Remarks _____

RECORD

Cased _____ in. _____ ft.
 Sand _____
 Gas _____
 Oil _____
 Total Depth _____

PRODUCTION

1st 24 hrs. Nat. _____
 1st 24 hrs. after shot _____
 Gas _____ cu. ft.
 Dry Hole _____
 Abandoned _____

Well No. 1-4344m Farm

Kenney-Costal Company

NORTH


1320 Ft. from N. Line

Ft. from S. Line

1320 Ft. from E. Line

Ft. from W. Line

1931

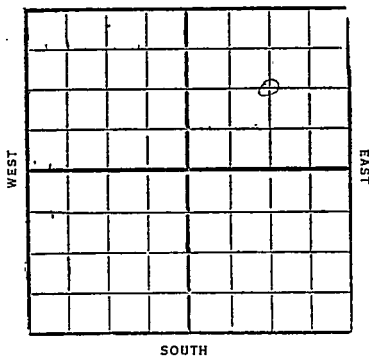

Date _____

REPORT

5/7	Run up
5/13	Wdg 1980'
5/20	T.D. 2560' Rust
5/27	—
6/3	T.D. 2772
	11 M gas
	Comp

Stevens

Map No. KANSAS Sec. 10 Twp. 35 R. 39^WWell No. 1 BlesawKimney - Costal Company

Contractor

FIRST REPORTS


1320 Ft. from N. Line

Ft. from S. Line

1320 Ft. from E. Line

Ft. from W. Line

SECTION PLAT

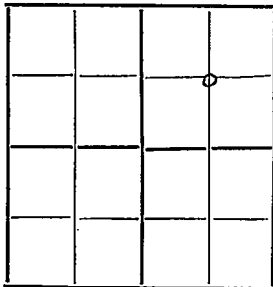

Location

Rig up

Drilling and Remarks:

Rigging up

RECORD

Cased _____ in., _____ ft.

Sand _____

Gas _____

Oil _____

Total Depth _____

PRODUCTION

1st 24 hrs. Nat. _____

1st 24 hrs. after shot _____

Gas _____ Cu. Ft.

Dry Hole _____

Abandoned _____

Date

MAY 7 1931

192

CHAS. L. SHERWOOD

Scout


KANSAS *Stevens*
 Map No. _____ Sec. *10* Twp. *35* R. *39* ^{W.}
 Well No. *1* *Bledow*
Kinney - Costal _____ Company
 _____ Contractor

COMPLETED*1320* Ft. from N. Line

_____ Ft. from S. Line

1320 Ft. from E. Line

_____ Ft. from W. Line

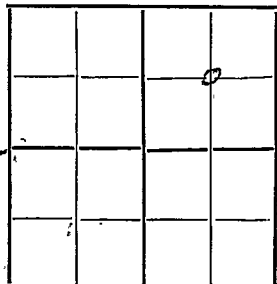SECTION PLAT

Location _____

Rig up _____

Drilling and Remarks:

RECORD

Cased _____ in., _____ ft.

Sand _____

Gas _____

Oil _____

Total Depth *2772***PRODUCTION**

1st 24 hrs. Nat. _____

1st 24 hrs. after shot _____

Gas *11* *AA* Cu. Ft.

Dry Hole _____

Abandoned _____

Date

JUN 3 1931

192

Scout