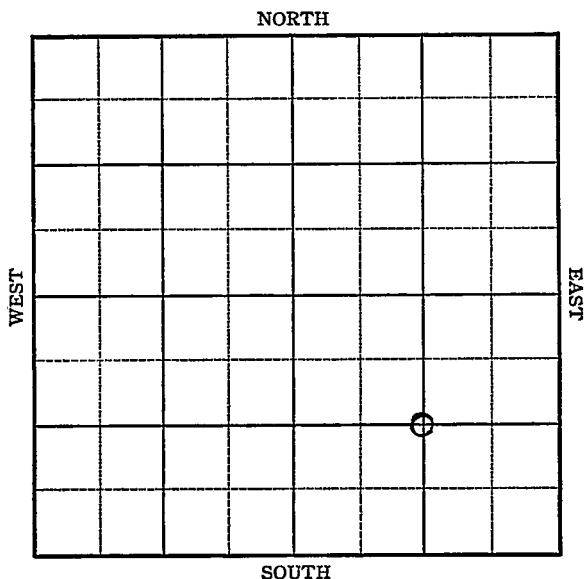


Section 10 Township 35 Range 38-WWell No. 1 HamiltonCompany Benedum & Trees

Stevens KANSAS

Map No. _____ Sec. 10 Twp. 35 R. 38WWell No. 1 Hamilton

Benedum & Trees

Company

Contractor

FIRST REPORT

C SE

_____ Ft. from N. Line

1320 Ft. from S. Line1320 Ft. from E. Line

_____ Ft. from W. Line

SECTION PLAT

Location _____

Rig up _____

Drilling and Remarks:

Matl

RECORD

Cased _____ in., _____ ft.

Sand _____

Gas _____

Oil _____

Total Depth _____

PRODUCTION

1st 24 hrs. Nat. _____

1st 24 hrs. after shot _____

Gas _____ Cu. Ft.

Dry Hole _____

Abandoned _____

Date

OCT 13 1937 19

H. D. Hatfield Scout

Stevens KANSAS

Map No. N 19 Sec. 10 Twp. 35 R. 38WWell No. 1 HamiltonBenedum & Trees

Company

Contractor

COMPLETED

C SE

 Ft. from N. Line1320 Ft. from S. Line1320 Ft. from E. Line Ft. from W. Line

SECTION PLAT

Location Rig up

Drilling and Remarks:

5 M,

RECORD

Cased 7 in., 2582 ft.Sand Gas Oil Total Depth 2835

PRODUCTION

1st 24 hrs. Nat. 1st 24 hrs. after shot Gas Cu. Ft.Dry Hole Abandoned

Date

NOV 23 1937 19

H. D. Hatfield

Scout