
Stevens

Form 51—5M—2-29—34703

Map No. KANSAS Sec. 10 Twp. 35 R. 38W

Well No. 1 Myers Farm

Trees Oil Company

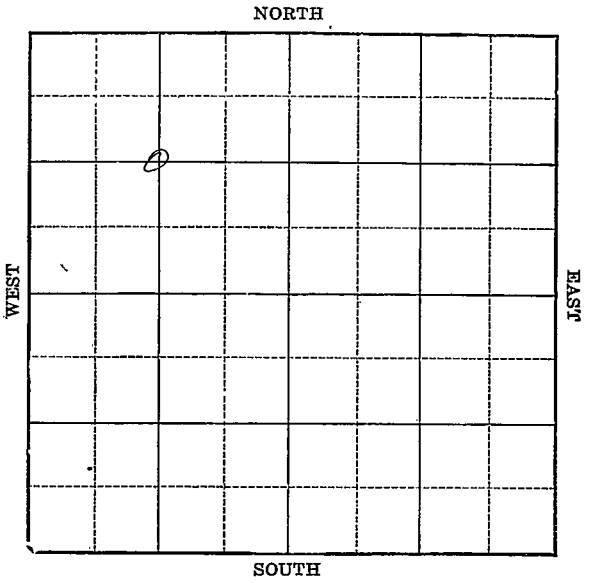

Location

Drilling Remarks

Rig Up

Drilling Remarks

RECORD

Cased ____ in. ____ ft.

Sand

Gas

Oil

Total Depth

PRODUCTION

1st 24 hrs. Nat.

1st 24 hrs. after shot

Gas ____ cu. ft.

Dry. Hole

Abandoned

Stevens

Form 252A—5M—11-29—38055

Map No. KANSAS Sec. 10 Twp. 35 R. 38w

Well No. 1 - Myers Farm

Trees Oil Company


1320 Ft. from N. Line

Ft. from S. Line

Ft. from E. Line

1320 Ft. from W. Line

1930

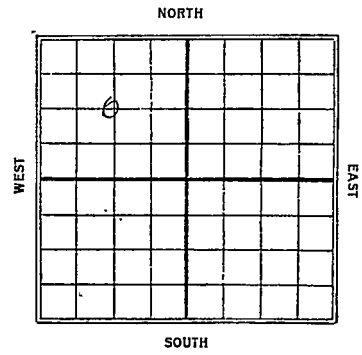

Date	REPORT
5/28	Bldg
6/4	Rigd up.
6/11	—
6/18	—
6/25	Hold. 2400'
7/2	Cust 2600'
7/9	Hold 2650 show gas.
7/16	Sand 2700-2797 T.D 2797 8 Mt Gas Comp.

Form 26—1M-Bks. 9-28

Stevens


Map No. KANSAS Sec. 10 Twp. 35 R. 38W

Well No. 1 Myers

Tree Oil Company

Contractor

SECTION PLAT

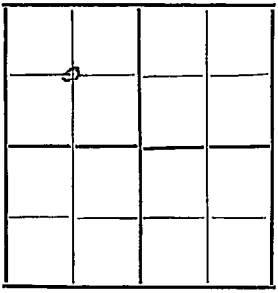

1320 Ft. from N. Line

Ft. from S. Line

Ft. from E. Line

1320 Ft. from W. Line

FIRST REPORTS

Location

Rig up

Drilling and Remarks:

Bur Clingrig

RECORD

Cased in., ft.

Sand

Gas

Oil

Total Depth

PRODUCTION

1st 24 hrs. Nat.

1st 24 hrs. after shot

Gas Cu. Ft.

Dry Hole

Abandoned

Date

MAY 28 1930

192

S. J. LEWIS Scout

Form 26 1M Bks. 2-29

Stevens


Map No. KANSAS Sec. 10 Twp. 35 R. 38W

Well No. 1 Myers

Texas Oil Company

Contractor

SECTION PLAT

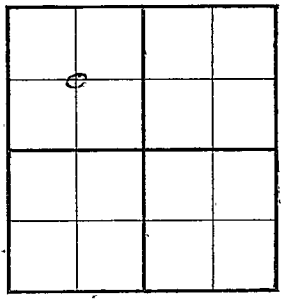

1820 Ft. from N. Line

_____ Ft. from S. Line

_____ Ft. from E. Line

1820 Ft. from W. Line

COMPLETED

Location _____

Rig up _____

Drilling and Remarks:

T M Gas

RECORD

Cased _____ in., _____ ft.

Sand 2600 - 2797

Gas _____

Oil _____

Total Depth 2797

PRODUCTION

1st 24 hrs. Nat. _____

1st 24 hrs. after shot _____

Gas _____ Cu. Ft.

Dry Hole _____

Abandoned _____

Date

JUL 16 1930 19____

S. J. LEWIS Scout