

Clark

KANSAS

SECTION 10 TOWNSHIP 35 RANGE 25W

WELL NO. #1^A Theis

COMPANY Shell Oil

NORTH

				0			

WEST

EAST

SOUTH

Clark

KANSAS

SEC. 10	TWP. 35	R. 25W
------------	------------	-----------

WELL NO. #1-Theis FARM

COMPANY Shell Oil

CONTRACTOR

WILDCAT


_____ Ft. from N. Line

330 _____ Ft. from S. Line

_____ Ft. from E. Line

363.2 _____ Ft. from W. Line

SW SW NE

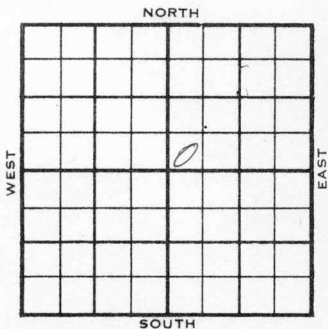

1956	ELEVATION	REPORT
------	-----------	--------

5-16 Location

County Clark Elev. _____
 Sec. 10 Twp. 35 Rge. 25W
 Company Shell Oil
 Farm Name Theis No. 1

TOPS	DEPTH	LOG	DATUM	Loc. in Sec.
Anh.				SW SW NE
TP.				330' SL
H.				363.2' WL
Tr.				
Dg.				
Bl.				Geol. _____
L.				Contr. _____
K.C.				
B.K.C.				
Ce.				
C.				
M.				Pool
M.				Wildcat
K.				
Mz.				
Me.				
V.				
S.				
S.				
A.				
R.				
PE.				
G.				
T.D.				

Date Comm. _____
 Location _____

Handwritten number 24

MAY 16 '56
 R.G.

Co.
 Lse.
 No.
 Sec.
 T.
 R.

County Clark Elev. 1991 DF
 Sec. 10 Twp. 35 Rge. 25W
 Company Shell Oil
 Farm Name Theis No. 1-17

TOPS	DEPTH	LOG	DATUM	Loc. in Sec.	
Anh. <u>Herr</u>	<u>2397</u>			SW SW NE 330' SL 363.2' WL	
TP. <u>WEd</u>	<u>2491</u>	<u>2484</u>	
H. <u>VIR</u>	<u>3440</u>	
Tr. <u>HO</u>	<u>4330</u>	
Dg.				Geol. _____	
Bl.	
L.	<u>4515</u>	<u>4511</u>		Contr. _____	
K.E. <u>Marm</u>	<u>5218</u>	<u>5208</u>	
B.K.C.				Pool _____	
Ce.	<u>5409</u>	<u>5406</u>	
E. <u>MW</u>	<u>5723</u>	<u>5721</u>		Wildcat	
M. <u>chest</u>	<u>5767</u>	<u>5766</u>	
M.				<table border="1"> <tr> <td></td> <td></td> <td></td> <td></td> </tr> <tr> <td></td> <td></td> <td></td> <td></td> </tr> <tr> <td></td> <td></td> <td></td> <td></td> </tr> <tr> <td></td> <td></td> <td></td> <td></td> </tr> <tr> <td></td> <td></td> <td></td> <td></td> </tr> <tr> <td></td> <td></td> <td></td> <td></td> </tr> <tr> <td></td> <td></td> <td></td> <td></td> </tr> <tr> <td></td> <td></td> <td></td> <td></td> </tr> <tr> <td></td> <td></td> <td></td> <td></td> </tr> <tr> <td></td> <td></td> <td></td> <td></td> </tr> </table>	
K.	
Mz.	
Me.	
V.	
S.	
S.	
A.	
R.	
PE.	
G.	
T.D.	<u>6100</u>			COMPLETE	

Date Comm. _____
 Location MAY 23 '56 MAY 29 '56 ✓ JUN 6 '56
Spd 99' East Skid rig
Spd 6-4-56 70" 120/250 JUN 13 '56
lost cor 13" 588/400 #2192
JUN 20 '56 9 5/8 @ 2367/1950 #3512
JUN 27 '56 ID 5200 JUL 3 '56 DST 5715-65
1hr run 75' Md FP 55-55 BHP
190/30 DST 5765-5867 70" 9 to

10-35-25 SW SW NE

S. 1" ga 1,830 MCF in 10"
 stabil @ 1,300 MCF in 1hr
 rec 300' Md FP 305-178
 BHP 1950/30" DST ~~5750~~ JUL 11
 DST 5867-5947 45" rec 10'
 Md BHP 20/25" 5 1/2 @ 6098
 1250 Co 5990 116/5836-65
 2" T69 Flow 5. Mill CF 1hr
 3 Mill in 4 hrs 1,500 MCF in
 16 hrs FTP 30 FCP 300 JUL
 ga 1,500 MCF end of 5 hr test
 RePF 87/5836-65 ga 1,500
 MCF ga 750 MCF on 12 hr
 test 20 ga 900 MCF
 FTP 30 CP 225# 48 hr test
 JUL 25 '56 ga 740 MCF SICP 130
 SITP 30 24/5804-12 40/570
 -78 To frac AUG 1" frac ga
 1,200 MCF TP 75 CP 300
 S.I. 24 hrs ga 900 MCF
 CP 275# AUG 8 '56 AUG 15 '56 S.I.
 AUG 22 '56 AUG 29 '56 SEP 5 '56 SEP 12 '56 SEP 19
 SEP 26 '56 OCT 3 '56 ✓ OCT 10 '56 OCT 17 '56
 OCT 24 '56 cal op Flow 3,100
 MCF & PD SIP 1473

10-35-25

SW SW NE