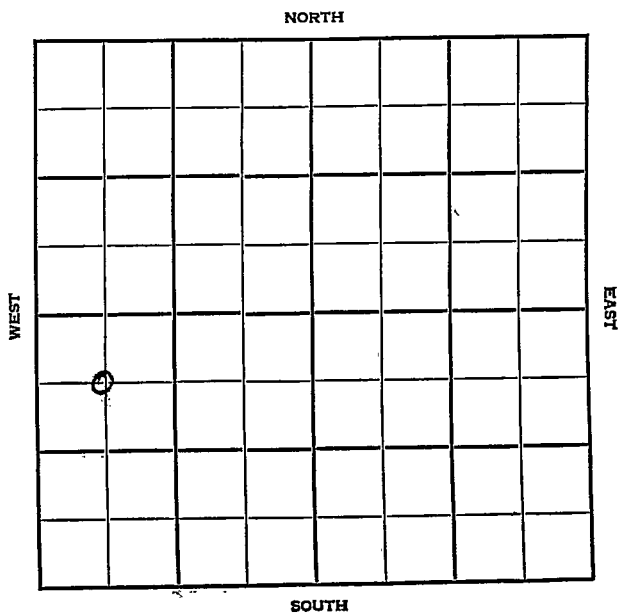


Section 10 Township 35 Range 17WWell No. 1 O'ConnellCompany Eason Oil Co.

SEC.	TWP.	R.
10	35	17W

WELL NO. #1 O'Connell FARM

COMPANY Eason Oil Co.

CONTRACTOR

Wildcat.

660

Ft. from N. Line


Ft. from S. Line

Ft. from E. Line

660

Ft. from W. Line

C NW SW

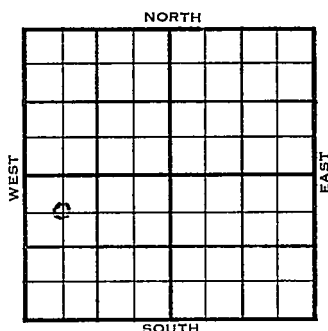

1954

ELEVATION

1962'

REPORT

Arb. Test.

5/12

Location

5/26

"

6/2

"

6/9

13" @ 227' w/200 sks

Drlg. 900'

6/23

Drlg. 3560'

6/30

" 5400

7/7

Drlg. 5997

7/21

Spud 6-4-54

D&A

TD 6815'

13" @ 227'

Wolfcamp 2588', Elgin 4410', Lans.

4766', Miss 5495', Woodfrod 5790',

Viola 5848', Simp. dol 6555', Simp

sd 6616', Arb. 6720'


TD 6815'

D&A

ABANDONED

J. G. McGEHEE

County Comanche State Kansas
 Sec. 10 (Blk.) 3 5 (Sur.) 17W Map No.
 Operator Eason Oil
 Well No. 1 Farm O'Connell
 Elev. 1962 Location C NW SW

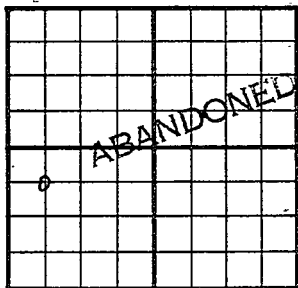

660 Ft. From N Line SW
660 Ft. From W Line Quarter
 Ist. Report
 Completion JUL 21 1954
 Remarks Wildcat

Spudding Date 6-4-54

Drlg. Data D & A TD 6815

13" @ 227 Wolfcamp 2588 Elgin 4410

Lams. 4760 Miss. 5495 Woodford 5790

Viola 5848 Simp. dol. 6555

Simpl sd. 6616 Arb. 6720 TD 6815

D & A