


DX 78-1

Barber KANSAS

Section 10 Township 35 Range 10W

Well No. 1 Gudeman

Company Aurora Gas & Berwick Drlg.

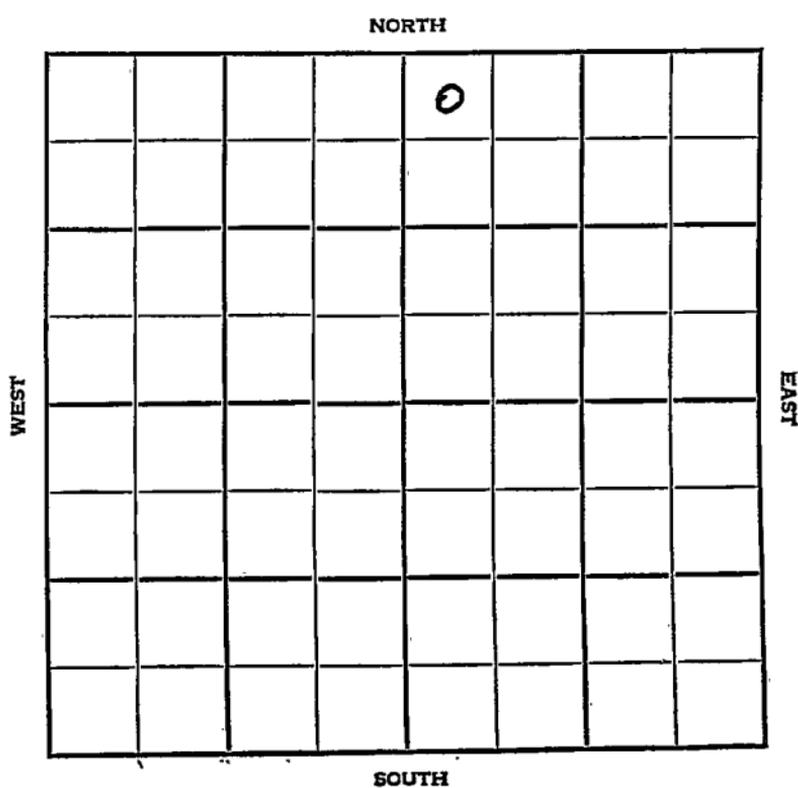

Barber KANSAS

SEC.	TWP.	R.
10	35	10W

WELL NO. **1 Gudeman** FARM

COMPANY **Aurora Gas & Berwick Drlg.**

CONTRACTOR **Berwick**


**Wildcat**

330 Ft. from N. Line

Ft. from S. Line

Ft. from E. Line

330 Ft. from W. Line

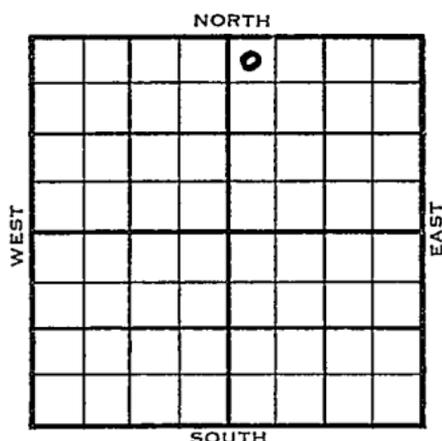

NW NW NE

Superior FO - Sup. & Sinc. - DHM

	ELEVATION	REPORT
1954	1285'	

9/8  
12/22

**Location**

Spud 10-15-54 Oil well TD 5489'  
 8-5/8" @ 200 Doug 3952 KC 4213  
 Cherokee 4659 Miss. 4727  
 DST 4732-50 open 1 hr rec 70' VSGCM  
 270# DST 4753-75 open 1 hr rec 5' SO  
 & GCM, 50' mud. 95# Viola 5152'  
 DST 5158-70 open 1 hr rec 600' gassy  
 oil, 180' muddy oil, 1100#  
 Stal. 3599 Br. lime 3919 KC 4213  
 DST 5225-50 open 1 hr rec 10' mud O#  
 Simp. 5242' DST 5289-5310 open 1 hr.  
 rec 3120' SW 2460# Arb. 5465'  
 TD 5485' Schl tops: Heeb 3619',  
 Tor. 3630 Doug 3655 Stal. 3953  
 KC 4213 Cherokee 4651' Miss 4725  
 Kh. 4941 Maq. 5099' Viola 5151  
 Simp. sh. 5242' Simp. sd. 5290'  
 Arb. 5461' TD 5489' 5" @ 5485  
 60/5153-62 F/10 BO S/1 1/2 BOPH 3 hr.  
 F/15 BO 12 hr. 3000 A F/46 BOPH  
 3 hr. F/240 BO 13 hr.  
 Comp. F/593 BOPD

**COMPLETED**

County Barber State Kansas

Sec. 10 (Blk. Twp.) 35 (Sur. Rge.) 10W Map No.

Operator Aurora Gas & Berwick Drlg.

Well No. 1 Farm Gudeman

Elev. \_\_\_\_\_ Location NW NW NE



330 Ft. From N Line NE

330 Ft. From W Line Quarter

1st. Report SEP 8 1954

Completion Superior farmout

Remarks Sup. & Sinc. - DHM

Berwick - Contr.

Spudding Date \_\_\_\_\_

Drlg. Data Wildcat

Location

---



---



FABEN GILSTRAP

☆

SEP 9 1954

Scout Cards .....	<i>AD</i>
Land Small Map .....	
Land Wall Map .....	
Tracings .....	<i>9</i>
France Map .....	
Glouce Map .....	
Misc. ....	


County Barber State Kansas

Sec. 10 (Blk.) 35 (Sur.) 10W Map No.

Operator Aurora Gas & Berwick Drlg.

Well No. 1 Farm Gudeman

Elev. 1285 Location NW NW NE

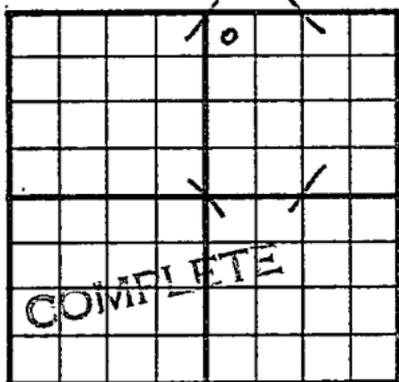

330 Ft. From N Line NE

330 Ft. From W Line Quarter

Ist. Report

Completion DEC 22 1954

Remarks Wildcat

Berwick - Contr.

Spudding Date 10-15-54

Drlg. Data Oil well TD 5489

8 5/8" @ 200 Doug. 3952 KC 4213

Cherokee 4659 Miss. 4727 DST 4732-50

open 1 hr. Rec. 70' vsgcm 270#

DST 4753-75 open 1 hr. Rec. 5' so & gcm

50' mud 95# Viola 5152 DST 5158-70

open 1 hr. Rec. 600' gassy oil 180'

muddy oil 1100# Stal. 3599 Br. lime

3919 KC 4213 DST 5225-50 open 1 hr.

Rec. 10' mud 0# Simp. 5242 DST 5289

5310 open 1 hr. Rec. 3120' sw 2460#

Arb. 5465 TD 5485 SCHLUMBERGER TOPS:

Heeb. 3619 Tor. 3630 Doug. 3655

Stal. 3953 KC 4213 Cherokee 4651

Miss. 4725 Kh. 4941 Maq. 5099

FABEN GILSTRAP

Orig. Date.

Viola 5151 Stimp. sh. 5242 Stimp. sd.

5290 Arb. 5461 TD 5489 5" @ 5485

60/ 5153-62 F/10 po. S/ 1 1/2 boph. 3 hr.

F/ 15 po 12 hr. 3000 A F/ 46 boph

3 hr. F/ 240 po 13 hr.

Comp. F/ 593 bopp

Scout Cards	<i>mm</i>
Land Small Map	
Land Wall Map	
Tracings	<i>3</i>
France Map	
Merce Map	

DEC 29 1954