


Section 10 Township 35 Range 8W
Well No. 1 Sellers Zellers
Company Aurora Gasoline

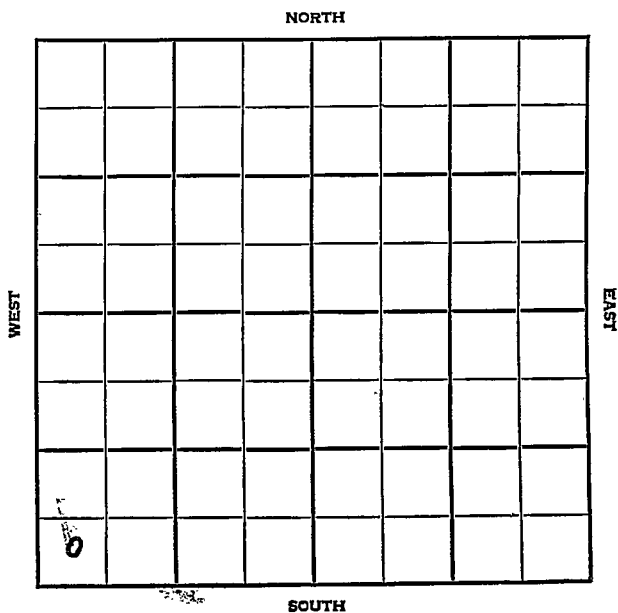

Harper KANSAS


SEC.	10	TWP.	35	R.	8W
WELL NO.	Zellers 1 Sellers FARM				
COMPANY	Aurora Gasolin				
CONTRACTOR					

_____ Ft. from N. Line

330 _____ Ft. from S. Line

_____ Ft. from E. Line

330 _____ Ft. from W. Line

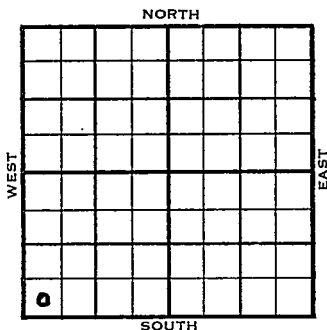

SW SW SW

Skelly - Support

	ELEVATION	REPORT
1955	1266'	
3/23	Location	
4/27	Spud 3-25-55 D & A TD 5585 8" @ 315 Heeb 3512 Doug 3580 DST 3571-3615 open 1 hr rec 125' MSW 120' SW 1480# Lans. 3860' Stal. 3872', KC 4168', B KC 4406' Checkerboard 4424', Marm. 4475', Cherokee 4609' DST 4578-4621, open 2 hr rec 210' gas, 30' SW 1690# DST 4659-4700 open 1 hr rec 15' mud 0# Cong. 4764' Miss 4770' DST 4772-83 open 2 hr gas in 32 min rec 15' SGCM 1800# DST 4792-4820 open 1 hr rec 1200' gas, 34' VSGCM 290# DST 4824-80 open 2 hr rec 1440' gas, 90' GCM 130# Kh. 5012' Viola 5276' DST 5278-91 open 1 hr. rec 30' GCM 0# Simp. 5310' DST 5330-45 open 1½ hr rec 1330' SW 220# Arb. 5564' TD 5585' D & A	

ABANDONED

MAR 25 1955

Scout Cards 140
Land Small Map 5
Land Wall Map 5
Tracings _____
France Map _____
Pierce Map _____
Misc. _____

Orig. Data

DX-201

SEC.

TWP.

B.

10

35

8W

WELL NO.

1 Zellers

FARM

COMPANY

Aurora Gasoline

CONTRACTOR

CORRECTION

SW SW SW

FT. FROM N. LINE

330

FT. FROM S. LINE

FT. FORM E. LINE

330

FT. FROM W. LINE

NORTH


SOUTH

Harper County

☐ LOCATION ☐ RIG UP DRILLING AND REMARKS: Reported #1 Sellers	RECORD PRODUCTION	CASED	IN.	FT.
		SAND		
		GAS		
		OIL		
		TOTAL DEPTH		
		1ST 24 HRS. NAT.		
		1ST 24 HRS. AFTER SHOT		
		GAS		CU. FT.
		DRY HOLE		
		ABANDONED		

DATE APR 6 1955	-SCOUT FABEN GILSTRAP
--------------------	--------------------------


57 1135

W L 083

APR 11 1955

Scout Cards	_____
Land Small Map	_____
Land Wall Map	_____
Tracings	_____
France Map	_____
Pierce Map	_____
Misc.	_____

County Harper State Kansas
 Sec. 10 (Blk.) 35 (Sur. Rge.) 8W Map No.
 Operator Aurora Gasoline
 Well No. 1 Farm Zellers
 Elev. 1266 Location SW SW SW

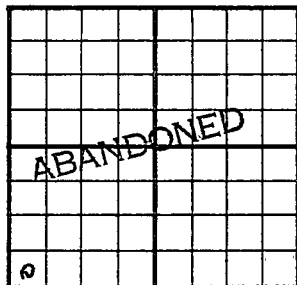

330 Ft. From S Line SW
330 Ft. From W Line Quarter
 1st. Report
 Completion APR 27 1955
 Remarks

Spudding Date 3-25-55

Drig. Data D & A TD 5585

8" @ 315 Heeb. 3512 Doug. 3580
DST 3571-3615 open 1 hr. Rec. 125' msw
120' sw 1480# Lans. 3860 Stal. 3872
KC 4168 B KC 4406 Checkerboard 4424
Marm. 4475 Cherokee 4609 DST 4578-4621
open 2 hr. Rec. 210' gas 30' sw
1690# DST 4659-4700 open 1 hr.
Rec. 15' mud 0# - Cong. 4764 Miss. 4770
DST 4772-83 open 2 hr. gas in 32 min.
Rec. 15' sgcm 1800# DST 4792-4820
open 1 hr. Rec. 1200' gas 34' vsgcm
290# DST 4824-80 open 2 hr. Rec.
1440' gas 90' gcm 130# Kh. 5012
Viola 5276 DST 5278-91 open 1 hr.

FABEN GILSTRAP

May 4 1956

Scout Cards *mm*

Long Small Map V 80


5564-7585

Trainers

open 1 1/2 hr. Rec. 1:30 PM MS

MS

#0 S. Imp. 53109


Rec. 301

Drig. Data