


KANSAS

Summer

Section 10 Township 35 Range 2-W

Well No. #3 Slentz

Company Champlin Ref.
Alton

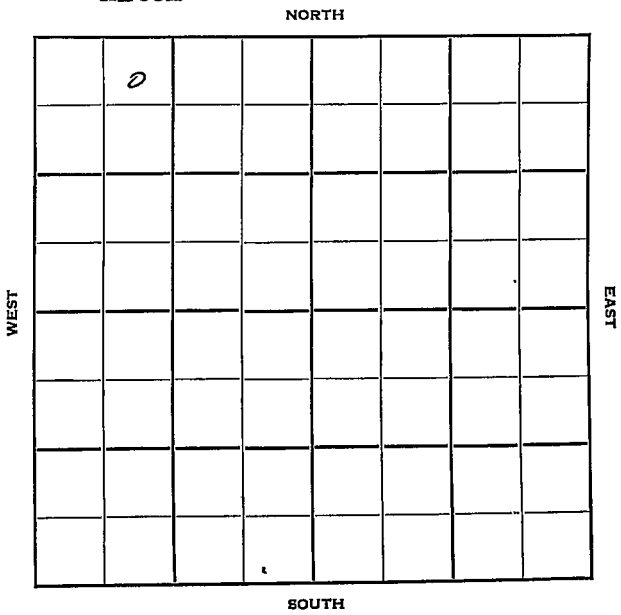

Summer
35

KANSAS
2W

Sec. 10 Twp. R. ✓

Well No. #3 Slentz Farm

Champlin Ref. Company

Contractor

Alton Pool


330' Ft. from N. Line

Ft. from S. Line

Ft. from E. Line

990' Ft. from W. Line

NE NW NW

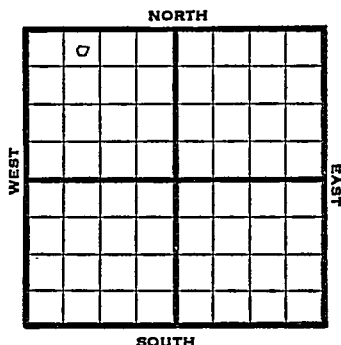

1950

Elev 1123'

REPORT

3/1

MIM

4/5

TD 4766'

10 3/4" @ 211'

Miss 4260'

Simp 4730'

D&A

Aband.

ABANDONED

Kansas

Map No. _____ Sec. 10 Twp. 35 R. 2WWell No. 3 Slentz

_____ Champlin Ref. _____ Company

_____ Contractor

NE NW NW

SECTION PLAT

<u>330</u>	Ft. from N. Line	0			
_____	Ft. from S. Line				
_____	Ft. from E. Line				
<u>990</u>	Ft. from W. Line	FIRST REPORT			

Sumner County

RECORD

Location _____

Cased _____ in., _____ ft.

Rig up _____

Sand _____

Drilling and Remarks:

Gas _____

Oil _____

Total Depth _____

M I M

PRODUCTION

1st 24 hrs. Nat. _____

1st 24 hrs. after shot _____

Gas _____ Cu. Ft.

Dry Hole _____

Abandoned _____

Date

MAR 1 1950J. E. TYRA Scout

Kansas

Map No. _____ Sec. 10 Twp. 35 R. 2WWell No. 3 Slentz

Champlin Ref.

Company


Contractor

NE NW NW

E/ 1123
SECTION PLAT330 Ft. from N. Line

_____ Ft. from S. Line

_____ Ft. from E. Line

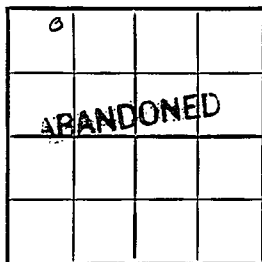990 Ft. from W. Line

Sumner County

Location _____

Rig up _____

Drilling and Remarks:

10 3/4" @ 211
 Miss 4260
 Simp 4730
 D & A

RECORD

Cased _____ in., _____ ft.

Sand _____

Gas _____

Oil _____

Total Depth 4766

PRODUCTION

1st 24 hrs. Nat. _____

1st 24 hrs. after shot _____

Gas _____ Cu. Ft.

Dry Hole _____

Abandoned _____

Date

APR 5 1951

J. E. TYRA

Scout